


SEE 1-00-002-C

-013
5.22 A.

Pa.B

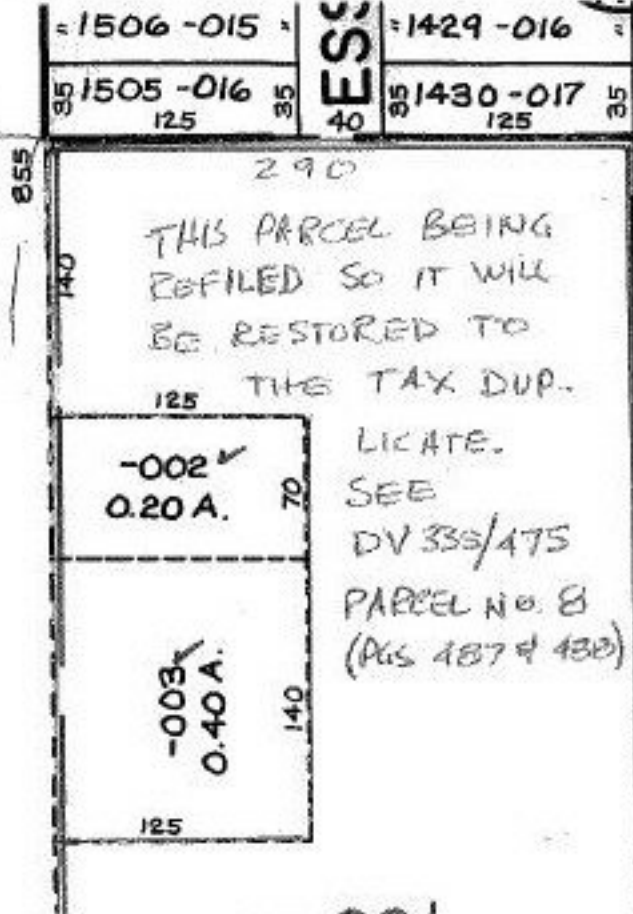

290
THIS PARCEL BEING REFILED SO IT WILL BE RESTORED TO THE TAX DUPLICATE.

-002 ✓
0.20 A.

SEE DV 335/475 PARCEL NO. 8 (PGS 487 & 488)

-003 ✓
0.40 A.

-001
4.57 A.

115

120

ADD TO DUP.

#22700-X


01-00-002-120-
SEE 01-00-003-139-017
65.90

APPROVED
LORAIN CO.
MAP DEPT.
DATE 11.3.98
BY T.M. Hain
22700-X

-004
3.50 A.

-008
5.79 A.


THORNWOOD

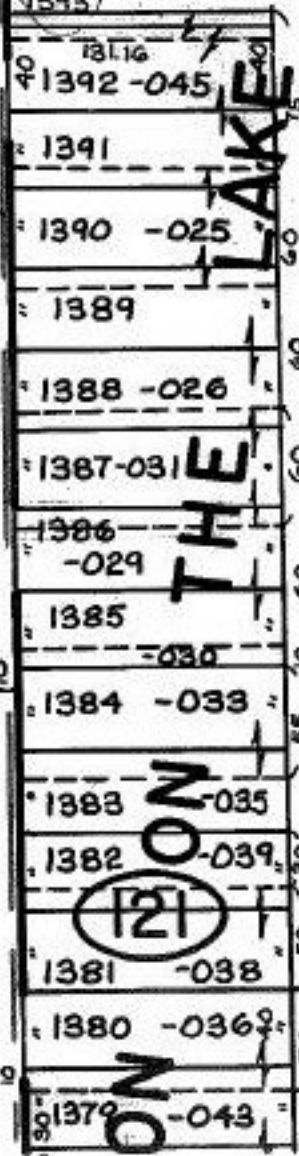

THE LAKE
ON
ON

121

SUBDIVISION

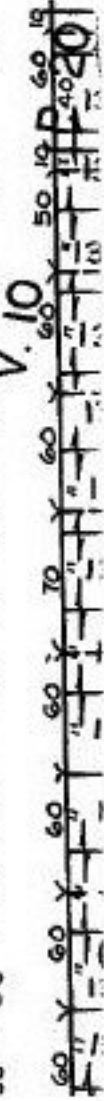

945

945

1945.02

1346.15

2-19-99
TS

1-00-002-D