

PARENT PARCEL: 21-17-010-000-025

CHILD PARCEL: XX-XX-XXX-XXX-XXX

STARTING POINT: MON. BOX, CL. OF BURSLEY RD. & CL. OF WEST RD.


NO. 22701-A

ACREAGE CORRECTION

21-17-010-000-025

~~43.00 A.~~

44.94 A.

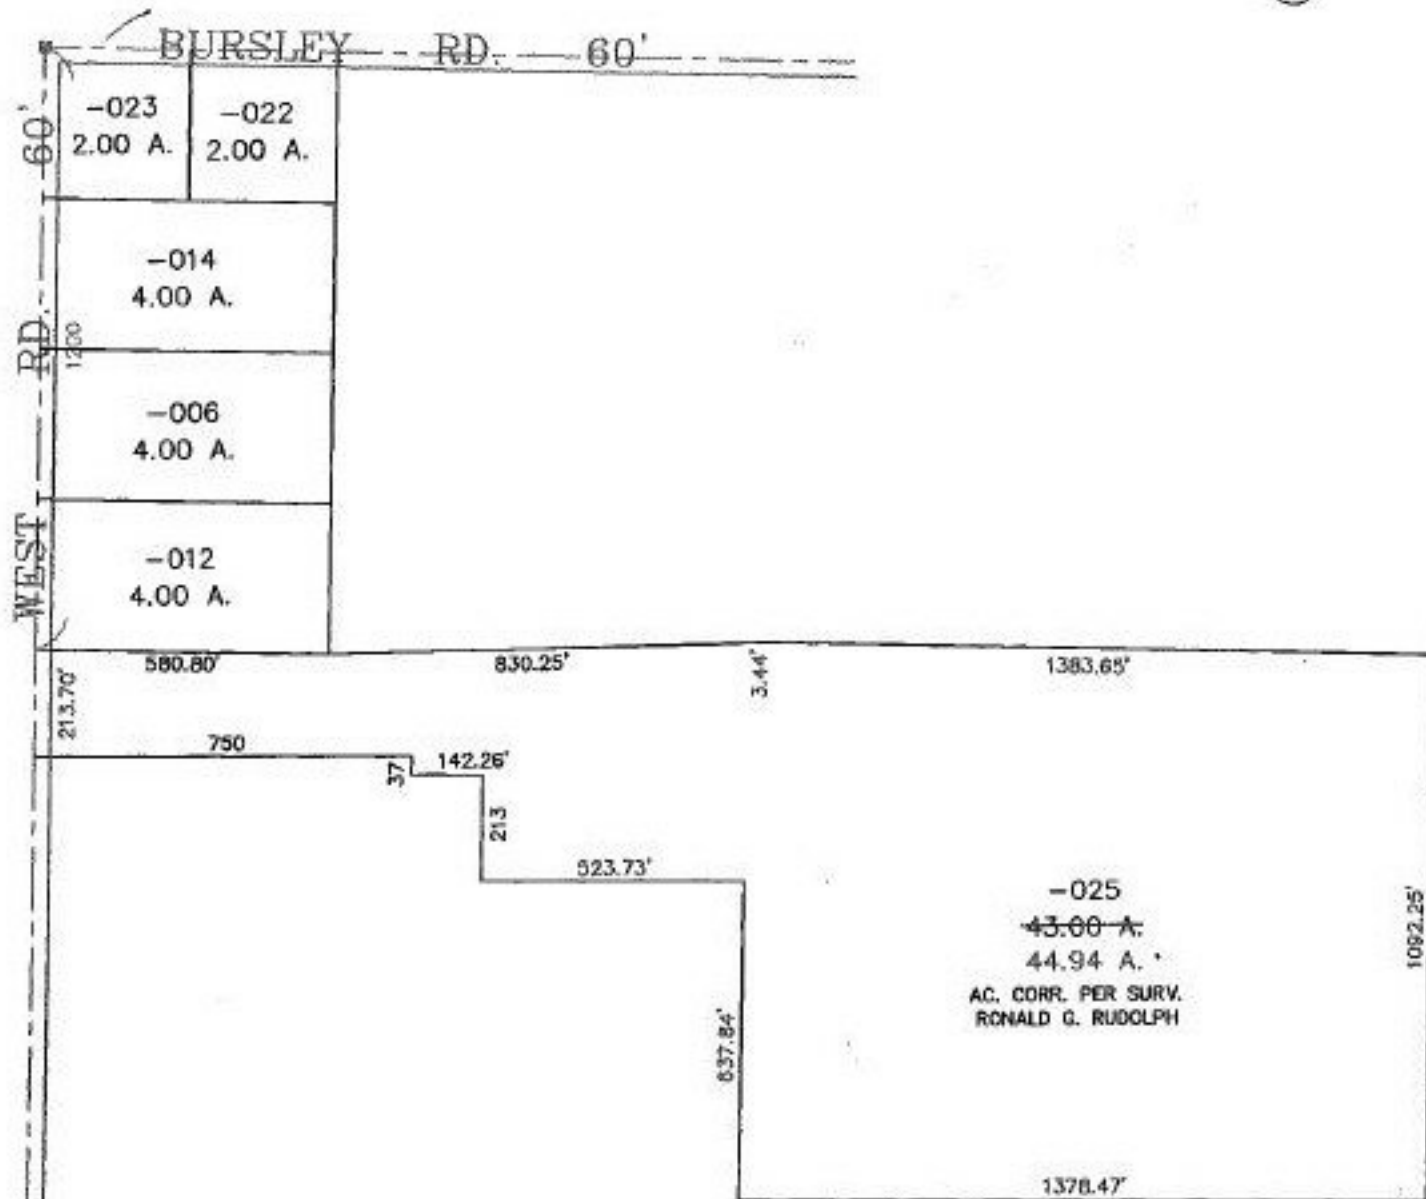

SPLITS/DEEDS PROCESSED
LORAIN COUNTY TAX MAP DEPARTMENT
 226 MIDDLE AVE. ELYRIA, OHIO

SURVEYED BY: RONALD G. RUDOLPH
 CLOSURE: 0.01 : 10,000
 MAP PAGE(S): 21-17-010-A & B
 APPROVED BY: T. SPILLMAN DATE: 11/19/98
 SCALE: 1" = 400' PRIOR INSTRUMENT: OR 1147/15