


72%
COPY
SIZE

-006
4.00A.

-012
4.00A.

ACRE. CORR. PER
SURVEY
RONALD G. RUDOLF
OCT. 29, 1998
PRIOR INST. REF.
OR 1147/15

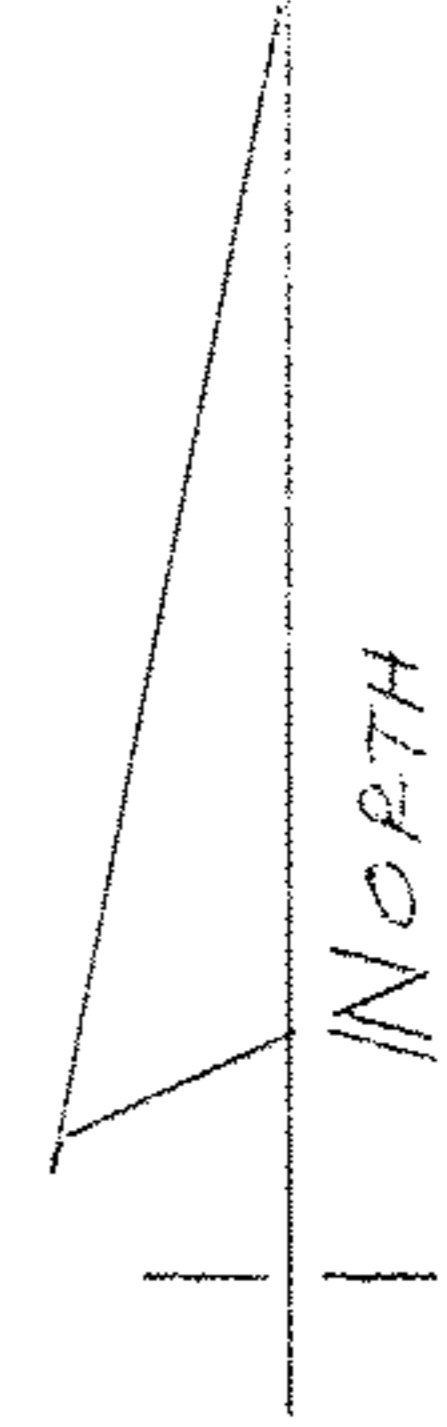

580.80

275.22

279.80

275.23

830.25



#22701

#22701-A

APPROVED
LORDAIN CO.
11-5-98
21-17-010-A
T. McHair
22701-A

-024
5.00 A.

PT. -025
~~PT. 49.00 A.~~
PT. 44.94 A.

750

37

142.26

213

523.73

892.26

1415.10

SEE 21-17-010-B

637.84

1413.36

300

300

213.36

213.70

250

SEE 21-D