


PARENT PARCEL: 12-00-028-000-007 & -008  
CHILD PARCEL: 12-00-028-000-040 THRU -042  
STARTING POINT: MON. BOX, CL OF BOONE RD. & NORTH LINE OF O.L. 28

NO. 22701

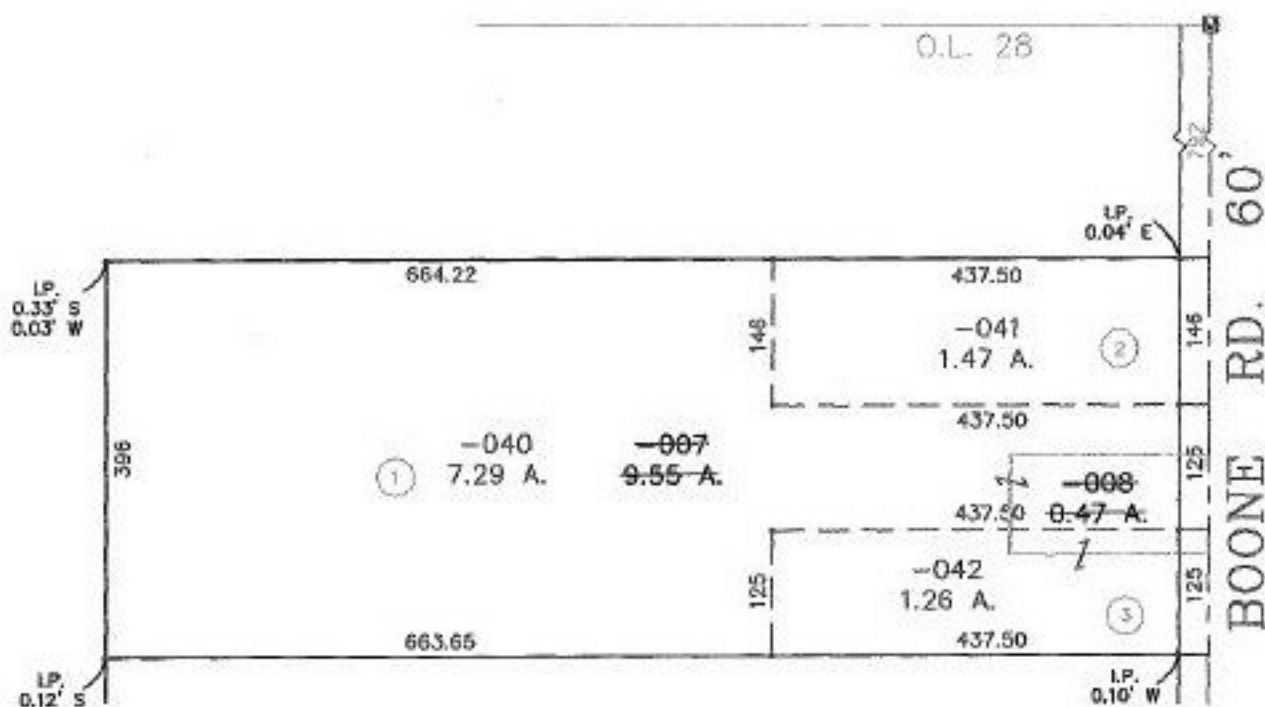

**SPLITS/DEEDS PROCESSED**  
LORAIN COUNTY TAX MAP DEPARTMENT  
226 MIDDLE AVE. ELYRIA, OHIO

SURVEYED BY: DONALD E. WOIKE  
CLOSURE: 0.00 : 10.000  
MAP PAGE(S): 12-G  
APPROVED BY: TJS DATE: 03/03/99  
SCALE: 1" = 200' PRIOR INSTRUMENT: OR 1177/423