


-028
0.45 A.

7700

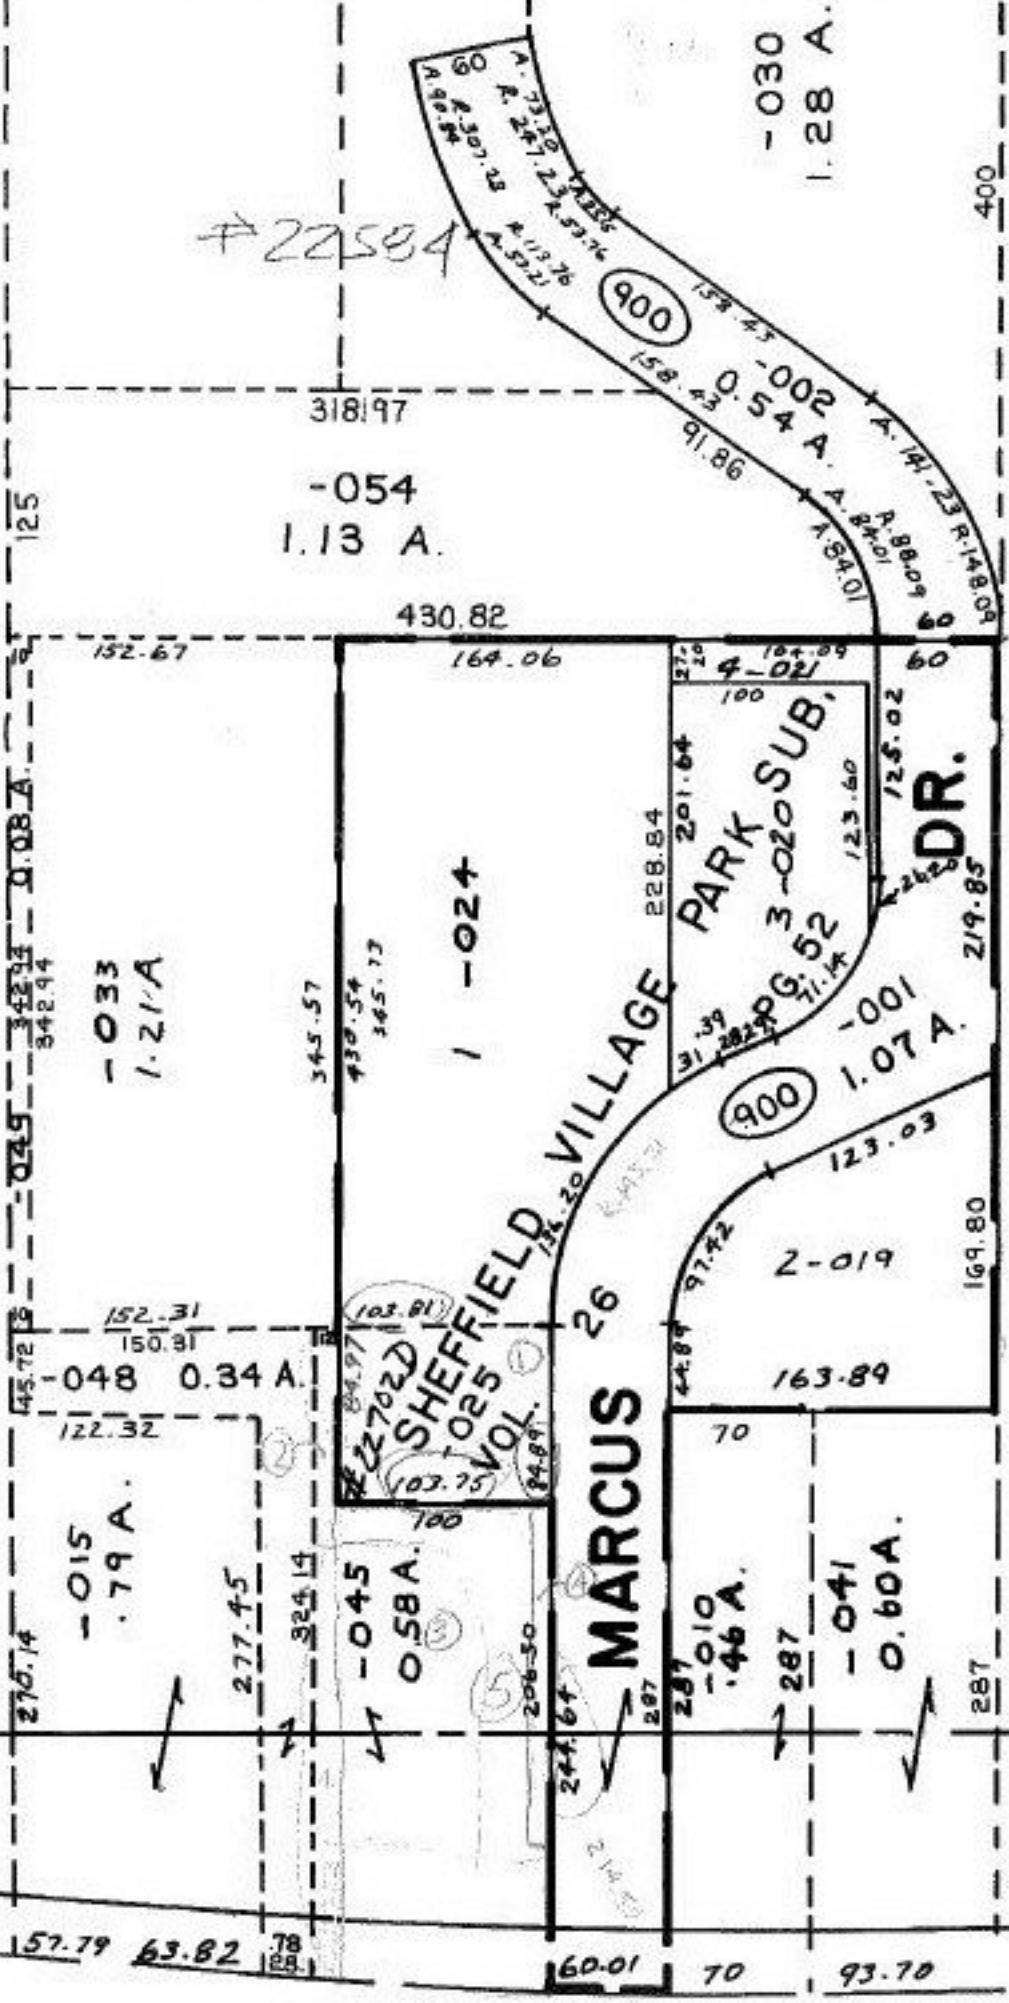

SEE 3-00-064-A