

PARENT PARCEL: 03-00-063-000-025

CHILD PARCEL: XX-XX-XXX-XXX-XXX

STARTING POINT: S.W. CORNER OF S\1, SHEFFIELD VILL. PARK SUB.

NO. 22702-D

PARCEL #1: FRONTAGE & DEPTH CORR.

03-00-063-000-025  
~~84.89 X 104~~  
84.89 X 103.80

PARCEL #2: PT. 03-00-063-000-045



PARCEL #3: PT. 03-00-063-000-045

PARCEL #4: PT. 03-00-063-000-045

PARCEL #5: PT. 03-00-063-000-045

ALL FOUR NEED TO BE WRITTEN  
TO THE CL OF COLORADO AVE., & COMBINED.  
NEED TO BE SURVEYED

PARCEL #6: 04-00-002-102-070 OK

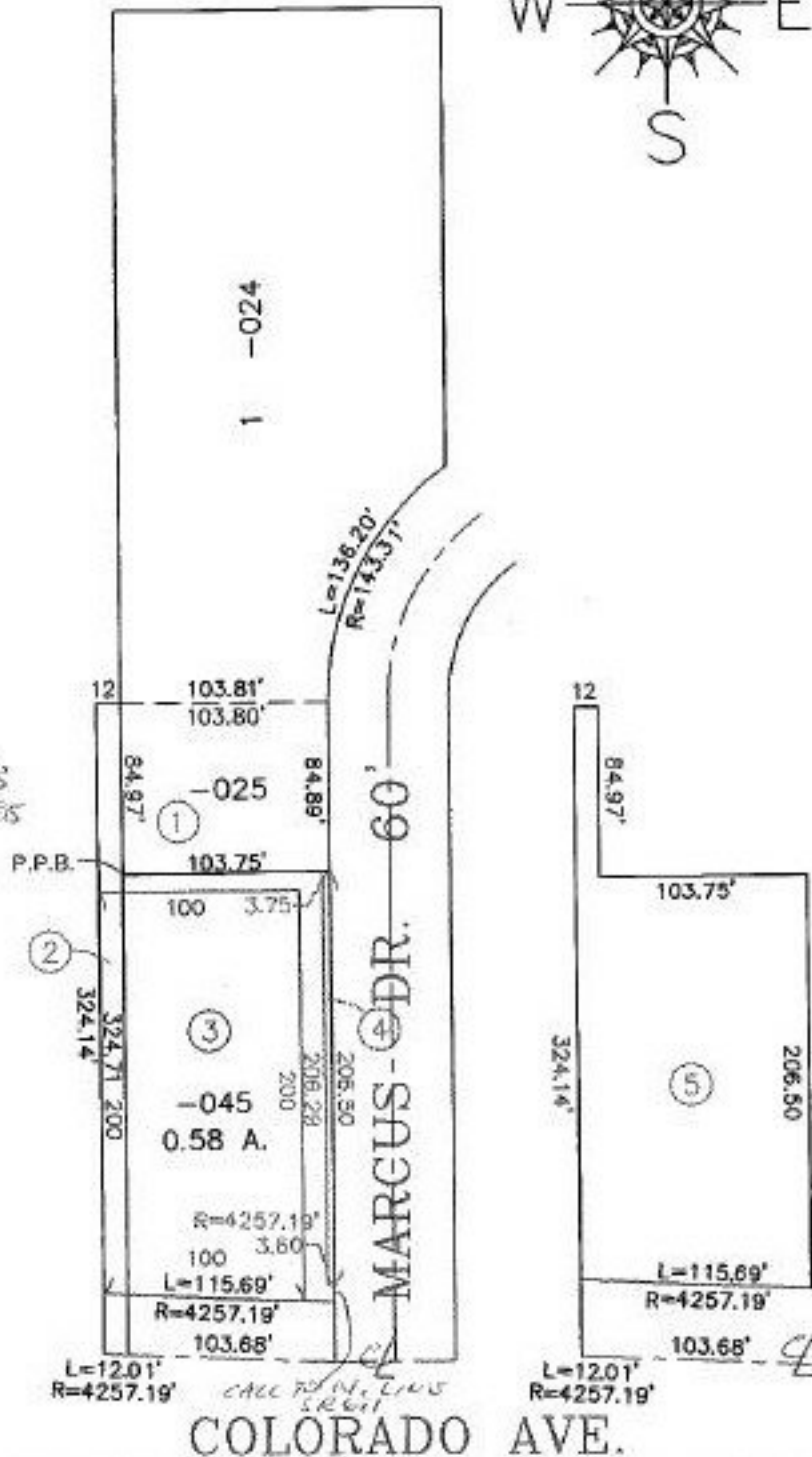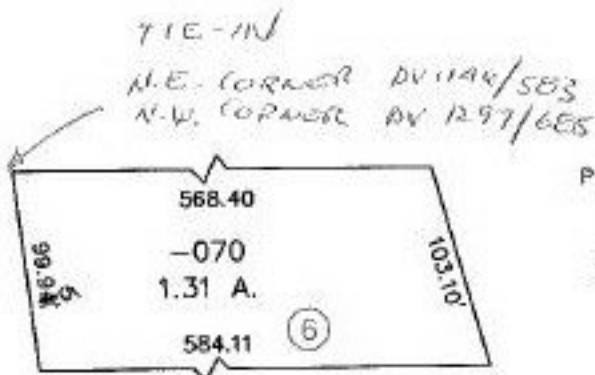

SPLITS/DEEDS PROCESSED

LORAIN COUNTY TAX MAP DEPARTMENT  
226 MIDDLE AVE. ELYRIA, OHIO

SURVEYED BY: DEED  
CLOSURE: 0.03 : 10,000  
MAP PAGE(S): 03-00-063. & 04-00-002-G  
APPROVED BY: IJS DATE: 11/11/98  
SCALE: 1" = 100' PRIOR INSTRUMENT: OR 1441/99