


PARENT PARCEL: 02-00-093-104-021


CHILD PARCEL: 02-00-093-104-024 & -025

STARTING POINT: NORTH R.O.W. OF E. 21st ST. & THE EAST R.O.W. OF ACCESS RD.

NO. 22703

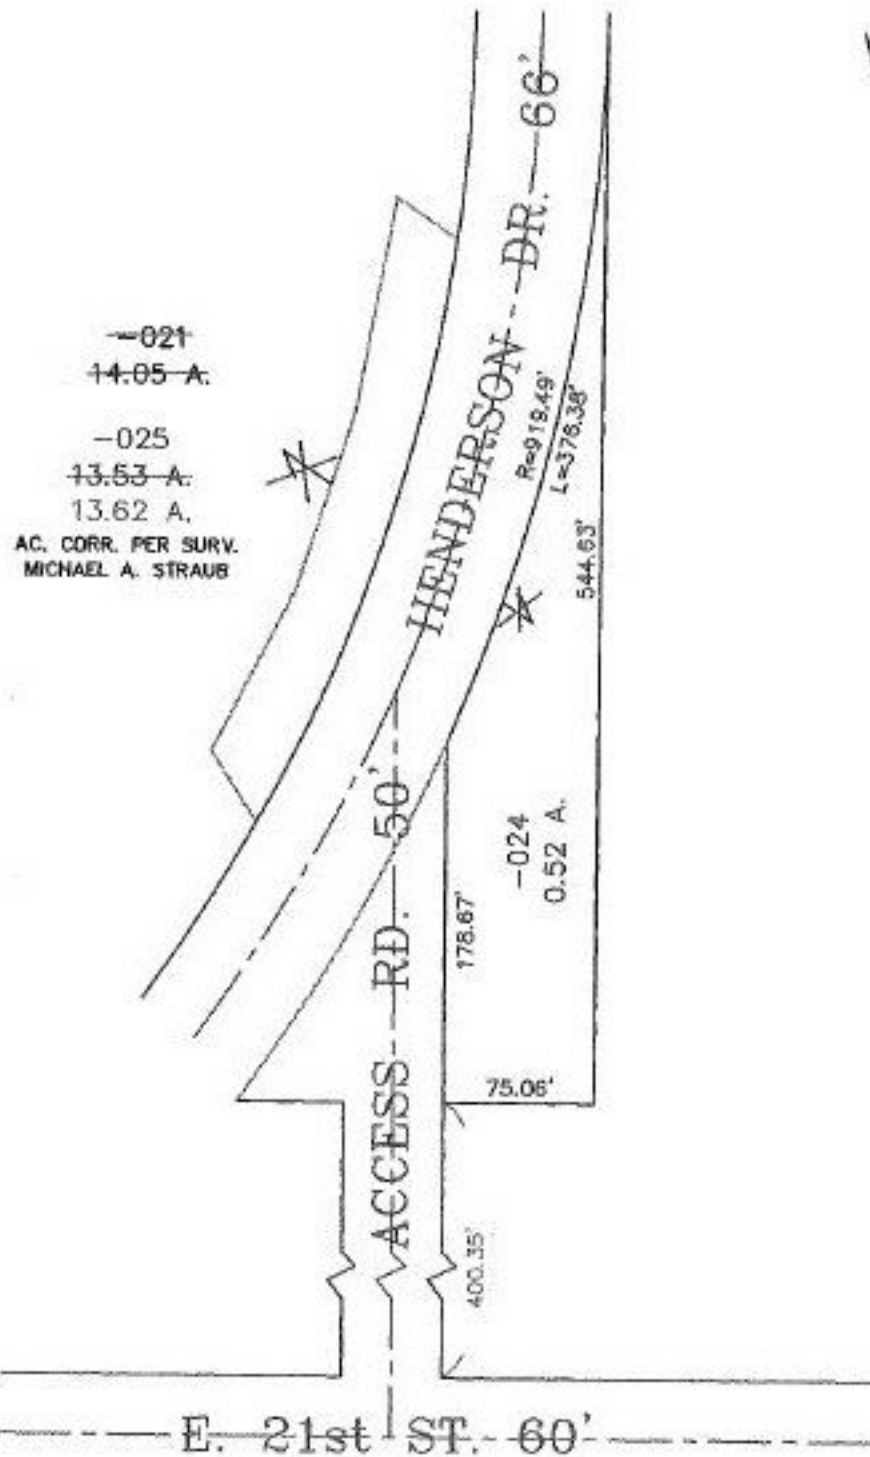

-021
14.05 A.
-025
13.53 A.
13.62 A.
AC. CORR. PER SURV.
MICHAEL A. STRAUB

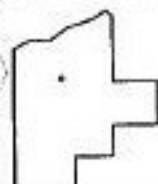

SPLITS/DEEDS PROCESSED
LORAIN COUNTY TAX MAP DEPARTMENT
226 MIDDLE AVE. ELYRIA, OHIO

SURVEYED BY: MICHAEL A. STRAUB
CLOSURE: 0.03 : 10,000
MAP PAGE(S): 02-00-052 & 02-00-093-B
APPROVED BY: T. SPILLMAN DATE: 12/02/98
SCALE: 1" = 100' PRIOR INSTRUMENT: DV 1230/734