

PARENT PARCEL: 03-00-097-116-045

CHILD PARCEL: 03-00-097-116-046 & -047

STARTING POINT: PARCEL #1: KNOWN AS S\L 115, PARCEL #2: KNOWN AS S\L 114

NO. 22704-U




UNCOMBINATION

PARCEL #'S


~~03-00-097-116-045~~
~~173.09 X 115.45 IRR.~~

03-00-097-116-046
35.26 X 120

03-00-097-116-047
38.09 X 121.57 TRI.

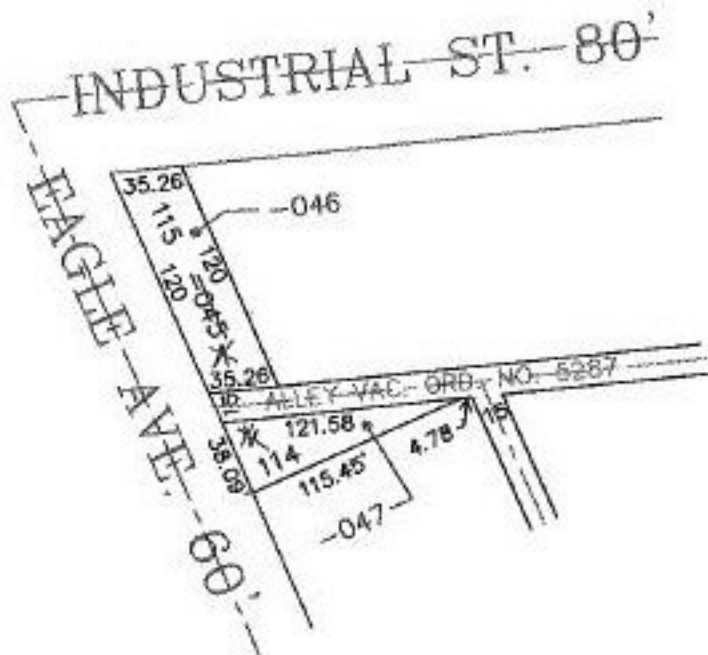

TJS
A-30-99

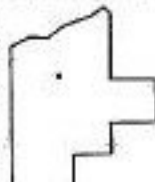

SPLITS/DEEDS PROCESSED

LORAIN COUNTY TAX MAP DEPARTMENT
226 MIDDLE AVE. ELYRIA, OHIO

SURVEYED BY: NONE

CLOSURE: CAN'T RUN

MAP PAGE(S): 03-00-097-A

APPROVED BY: TJS DATE: 11/06/98

SCALE: 1" = 100' PRIOR INSTRUMENT: OR 744/765