


PARENT PARCEL: 09-00-081-000-037

CHILD PARCEL: 09-00-081-000-052, & -053

STARTING POINT: MON. BOX, CL. OF OBERLIN-NORWALK RD. & CL. OF QUARRY RD.

NO. 22711

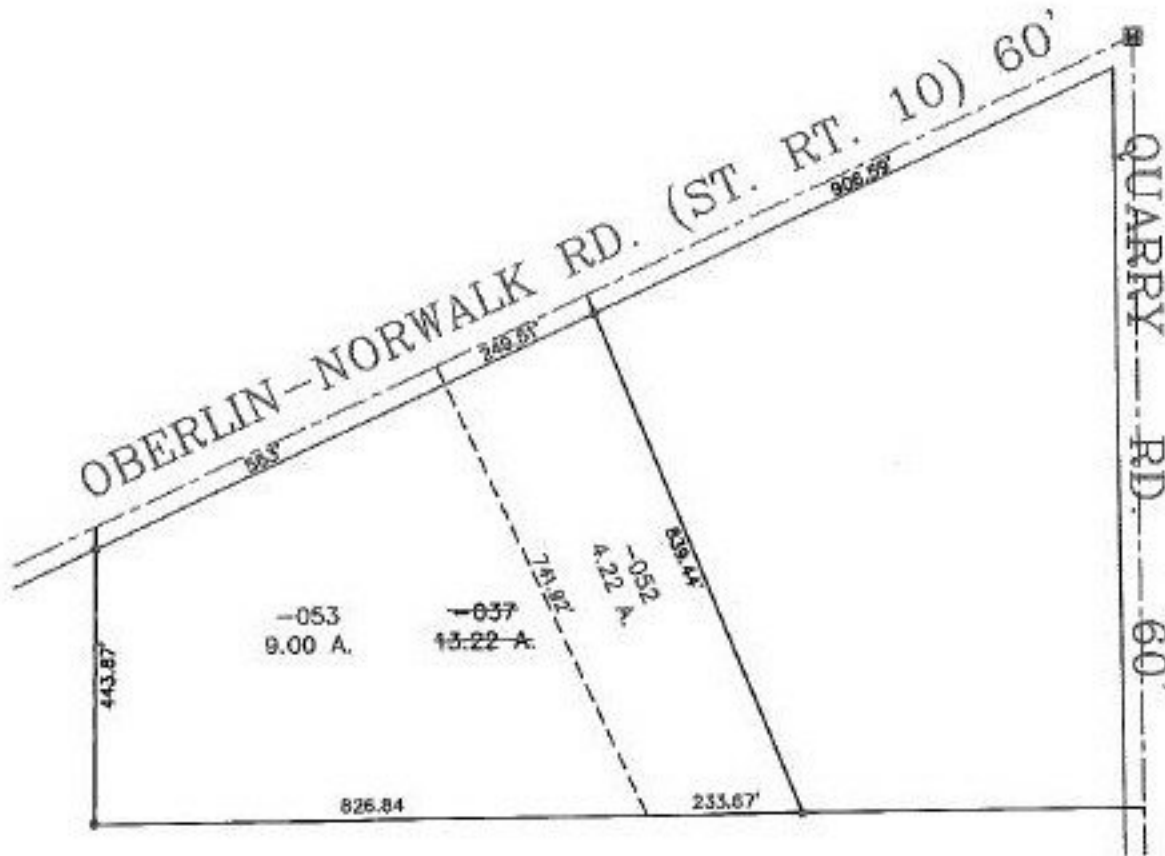

SPLITS/DEEDS PROCESSED
 LORAIN COUNTY TAX MAP DEPARTMENT
 226 MIDDLE AVE. ELYRIA, OHIO

SURVEYED BY: THOMAS M. SNEZEK
 CLOSURE: 0.04 : 10,000
 MAP PAGE(S): 9-E
 APPROVED BY: I. SPILLMAN DATE: 12/02/98
 SCALE: 1" = 300' PRIOR INSTRUMENT: OR 656/275

Handwritten signature/initials