

PARENT PARCEL: 04-00-016-101-093

CHILD PARCEL: XX-XX-XXX-XXX-XXX


STARTING POINT: XXXXXX

NO. 22712 X



# CERTIFICATE OF CORRECTION

PLAT VOL. 60 PG. 5  
04-00-016-101-093  
~~46 X 80~~  
46.16 X 80.00

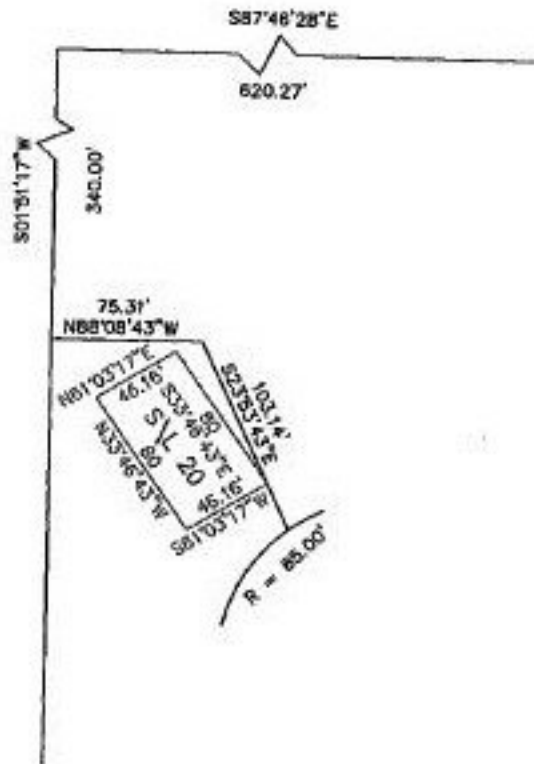

**SPLITS/DEEDS PROCESSED**  
LORAIN COUNTY TAX MAP DEPARTMENT  
226 MIDDLE AVE. ELYRIA, OHIO

SURVEYED BY: DONALD E. HIMES  
CLOSURE: 0.00 : 10.000  
MAP PAGE(S): 04-00-016-F  
APPROVED BY: T. SPILLMAN DATE: 11/30/98  
SCALE: 1" = 100' PRIOR INSTRUMENT: PV 60, P. 4&5