


22716-D

APPROVED
LORAIN CO.
MAP DEPT.
DATE: 5-1-99
BY: (2-00-003-A)
T.M. Young
22716-D

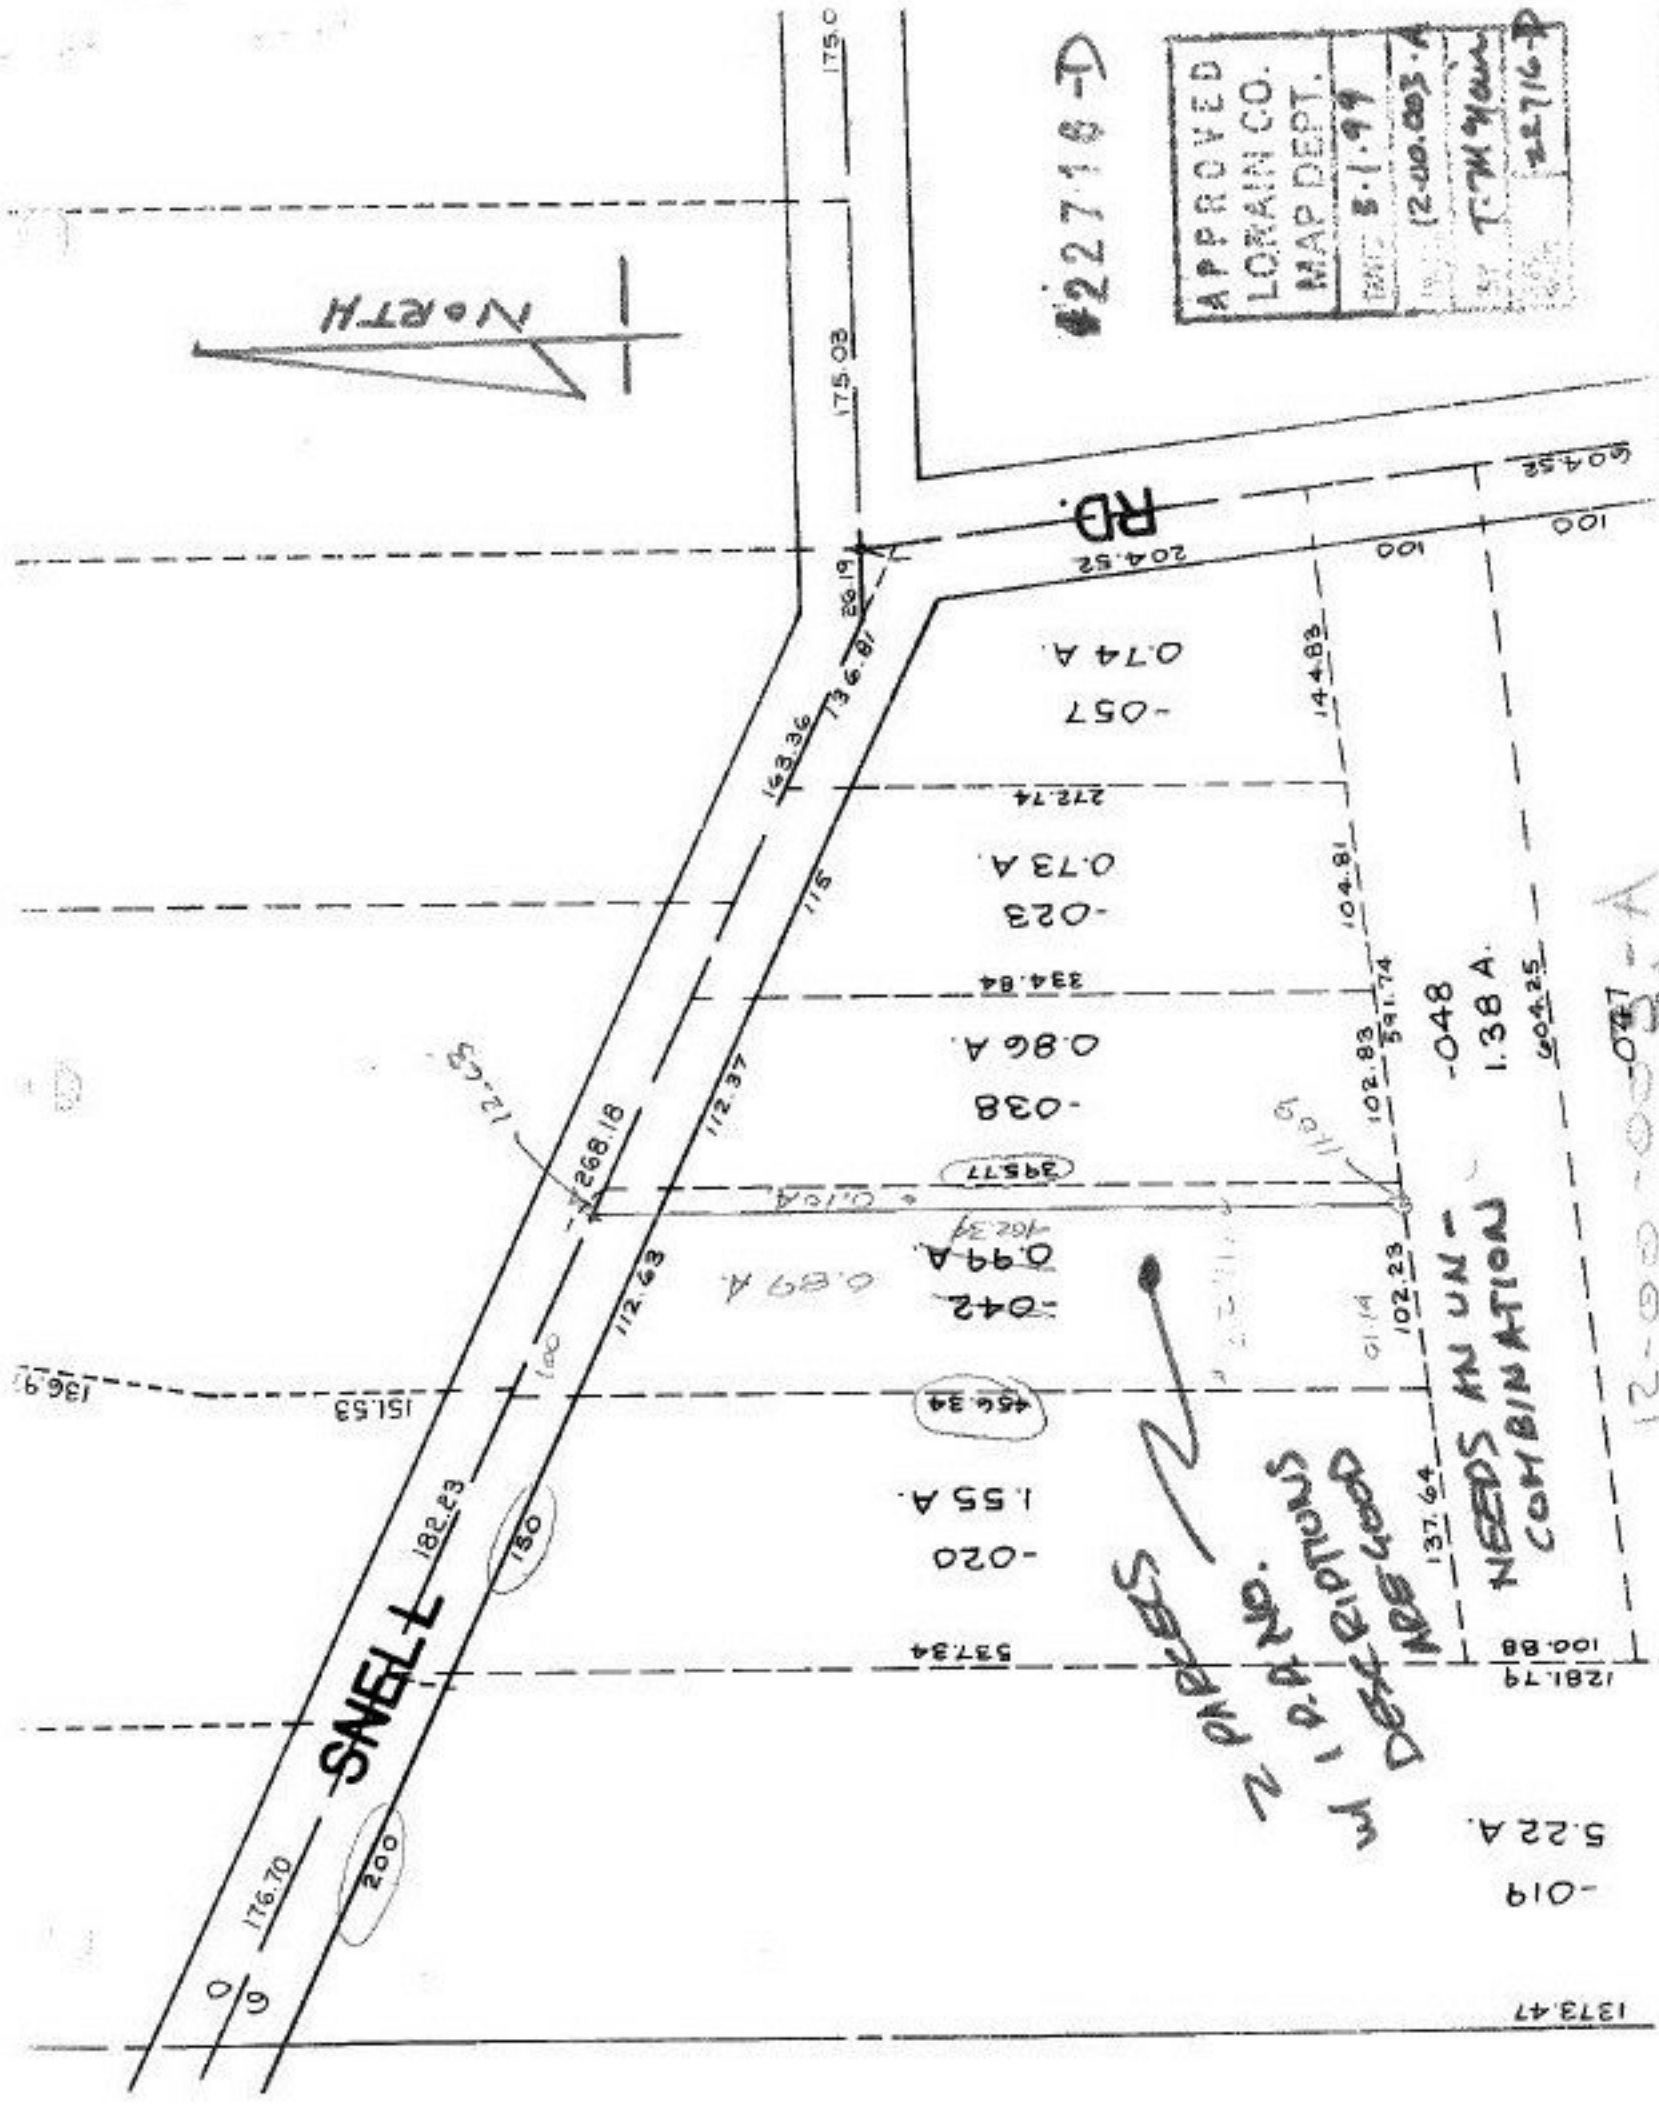

2 PAPERS
 2 P.P. NO.
 w/ 1 P. P. NO.
 ARE GOOD

NEEDS AN UN-
 COMBINATION

12-00-0007-A

5.22 A
 -019

1281.79
 100.88

137.64

102.23
 01.14

102.83
 591.74

104.81

14.83

604.52

RD.

204.52

0.74 A
 -057

272.74

0.73 A
 -023

334.84

0.86 A

-038

395.77

0.99 A

-042

456.34

1.55 A

-020

537.34

0.89 A

0.10 A

112.37

112.63

158.36

136.87

26.19

12.63

266.18

182.23

176.70

0

136.97

151.53

175.0

175.03

175.03

