


PARENT PARCEL: 14-00-056-000-009, & -004


CHILD PARCEL: 14-00-056-000-014 THRU -016

STARTING POINT: R.R.S. AT THE CL OF HUGHS RD. & CL OF HALLAUER RD.

NO. 22716

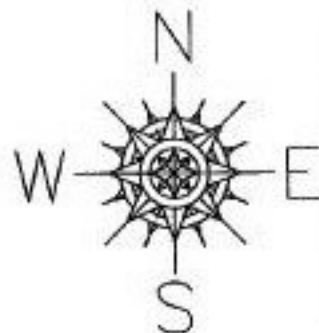

● I.P. FD  
● R.R.S

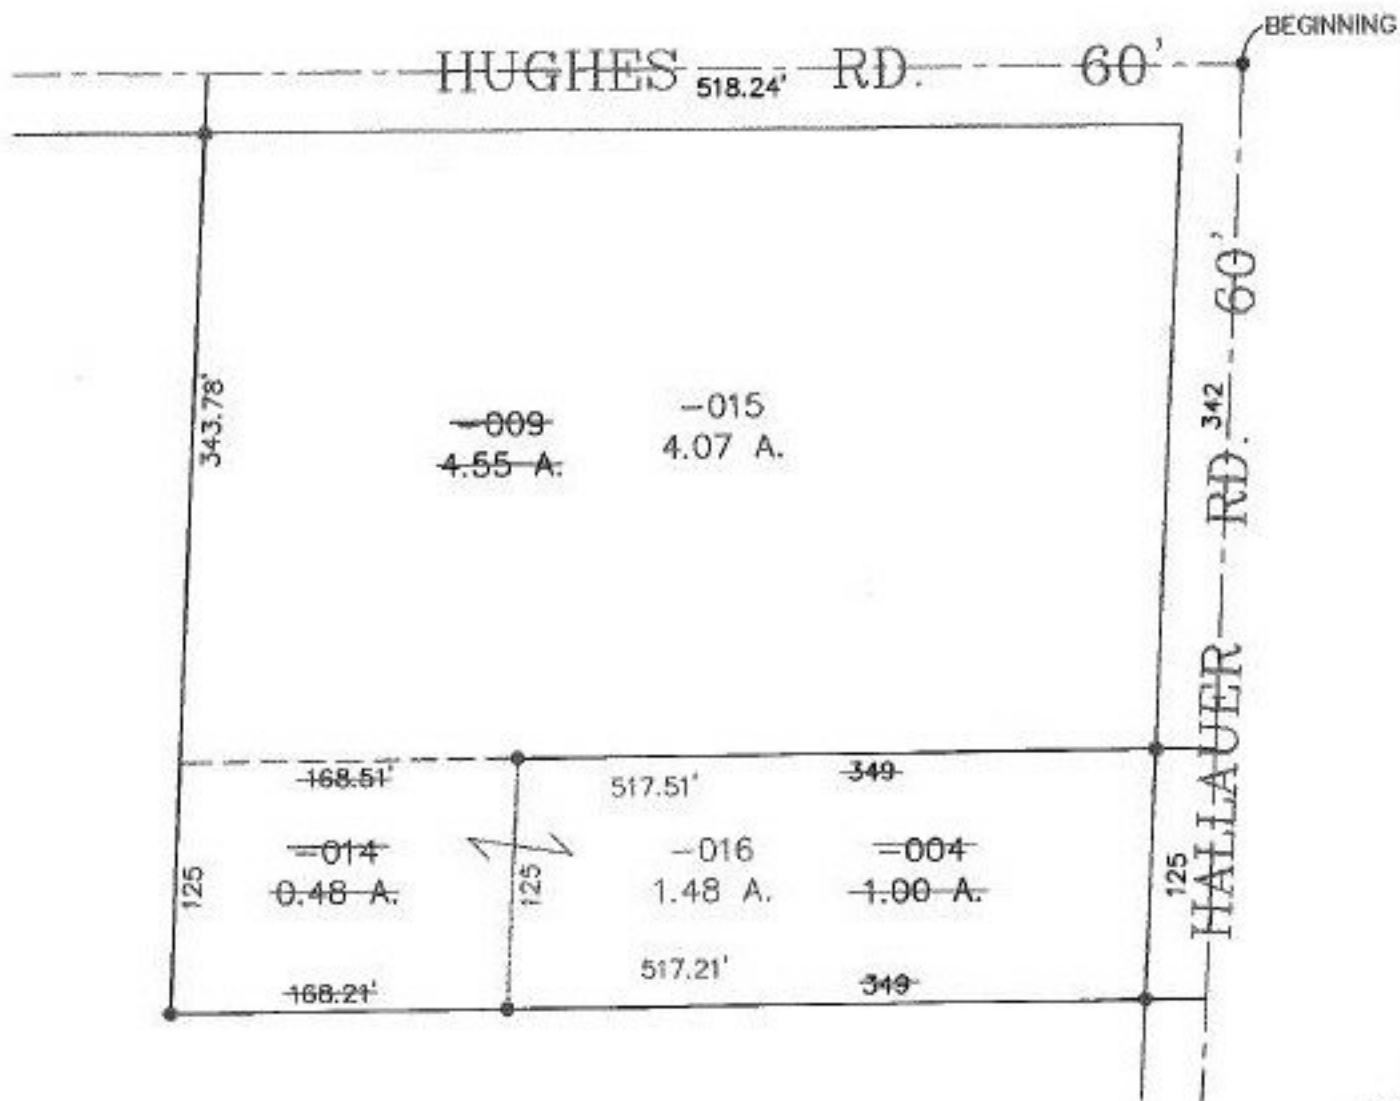

PRIOR INSTRUMENT: DV 608/413  
PRIOR INSTRUMENT: 980574899

4-24-99  
M.S.



**SPLITS/DEEDS PROCESSED**

LORAIN COUNTY TAX MAP DEPARTMENT  
226 MIDDLE AVE. ELYRIA, OHIO

SURVEYED BY: EARL H. HUNTER  
CLOSURE: 0.28 : 10,000  
MAP PAGE(S): 14-C  
APPROVED BY: I. SPILLMAN DATE: 11/25/98  
SCALE: 1" = 100'