

PARENT PARCEL: 12-00-023-000-063


CHILD PARCEL: XX-XX-XXX-XXX-XXX

STARTING POINT: I.P., CL OF SNELL RD. & CL OF BOONE RD.

NO. 22730-A



SNELL RD. 60'

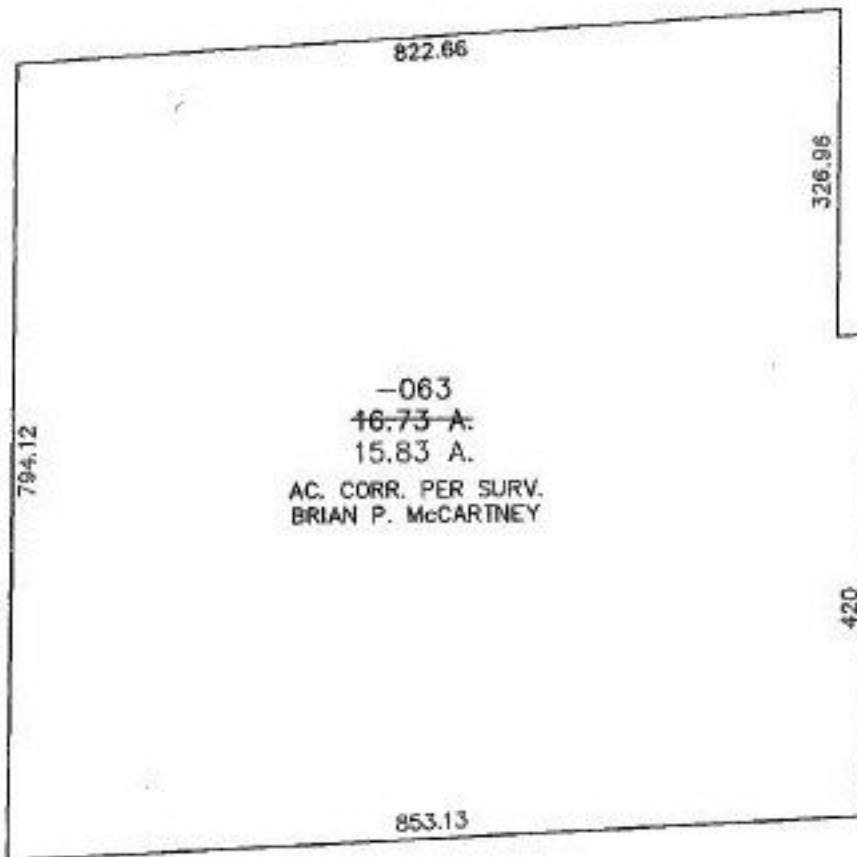

681.90 60'

RD.

BOONE

P.K. NAIL



**SPLITS/DEEDS PROCESSED**  
LORAIN COUNTY TAX MAP DEPARTMENT  
226 MIDDLE AVE. ELYRIA, OHIO

SURVEYED BY: BRIAN P. McCARTNEY  
 CLOSURE: 0.02 : 10.000  
 MAP PAGE(S): 12-00-023-B  
 APPROVED BY: TJS DATE: 12/24/98  
 SCALE: 1" = 200' PRIOR INSTRUMENT: OR 972/940