
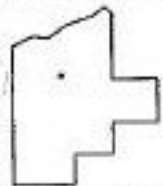


PARENT PARCEL: 04-00-021-000-156

CHILD PARCEL: 04-00-021-000-159 THRU -162

STARTING POINT: PARCEL 1 & 3: MON. BOX, CL OF CHESTER RD. & CL OF LEAR NAGLE RD.
PARCEL 2: I.P. FD. (BRANHALL) AT THE N.W. CORNER OF LEAR INDUSTRIAL PARK SUB. 1

NO. 22730

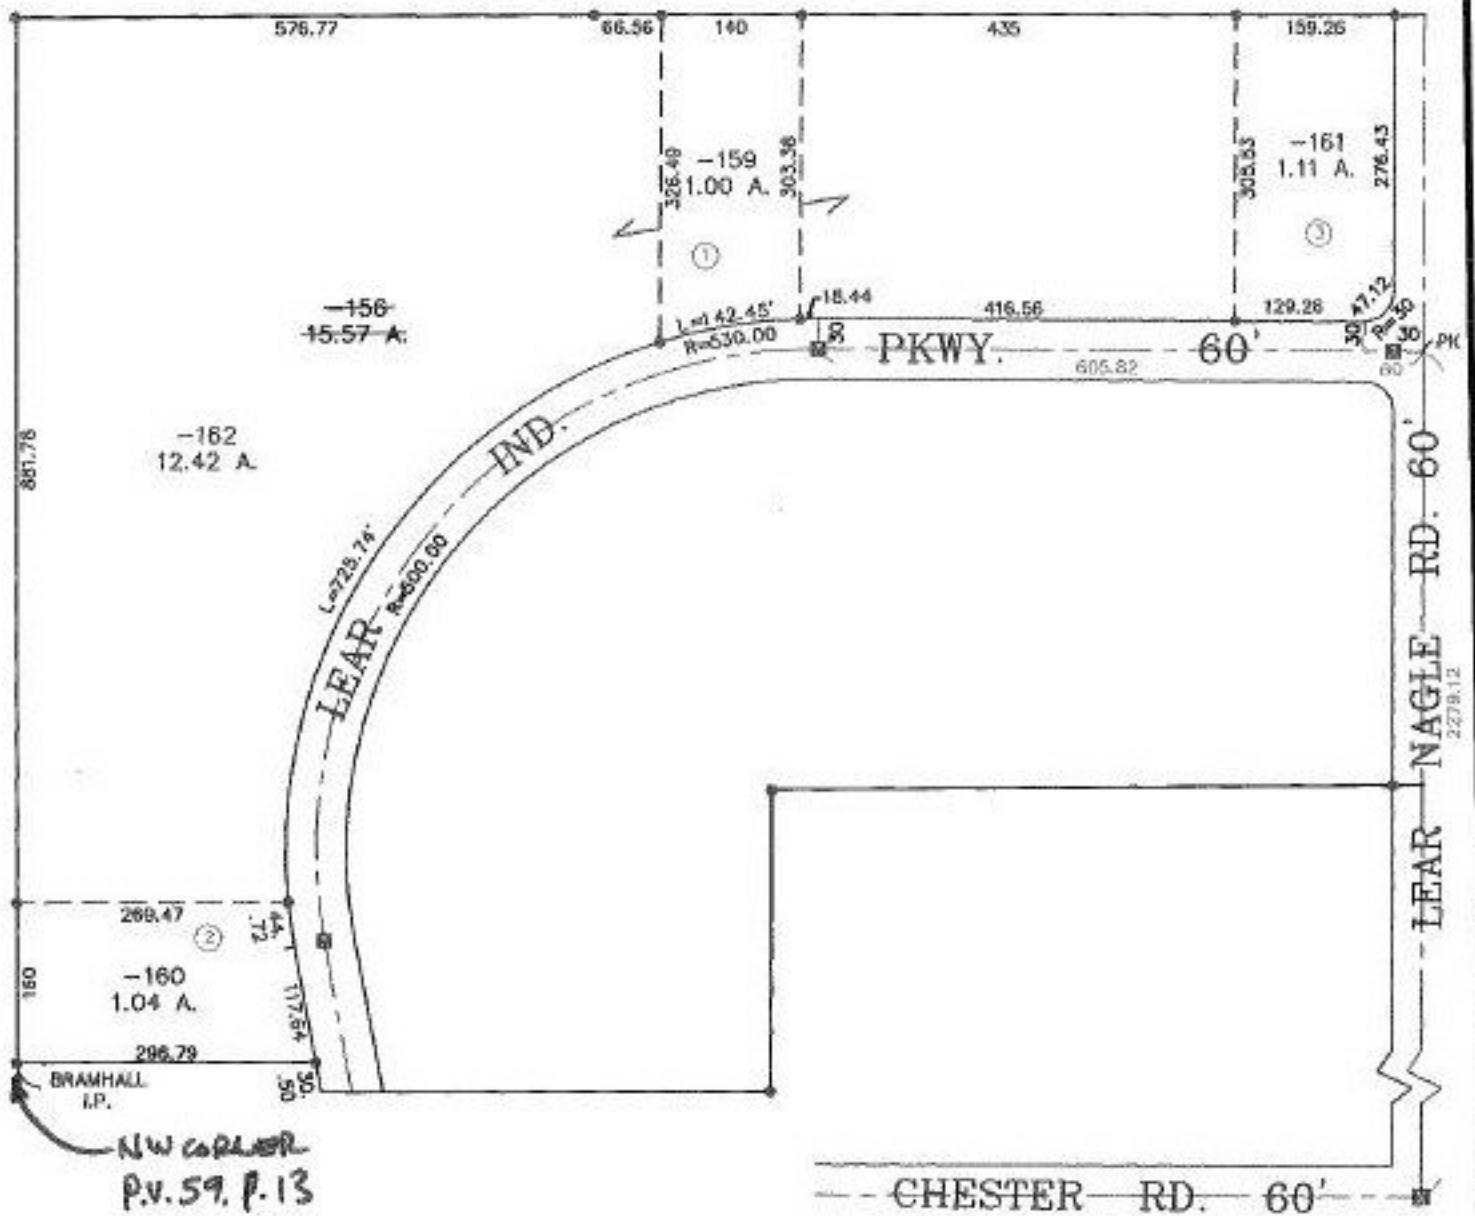

SPLITS/DEEDS PROCESSED
LORAIN COUNTY TAX MAP DEPARTMENT
226 MIDDLE AVE. ELYRIA, OHIO

SURVEYED BY: RICHARD A. THOMPSON JR.
CLOSURE: 0.11 : 10,000
MAP PAGE(S): 4-G
APPROVED BY: TJS DATE: 12/29/98
SCALE: 1" = 200' PRIOR INSTRUMENT: OR 1303/813