


PARENT PARCEL: 04-00-025-000-018, 022, 023, 208, 220, 222, 225


CHILD PARCEL: 04-00-025-000-226

STARTING POINT: C/Ls LEAR NAGLE ROAD & RESERVE WAY

NO. 22735

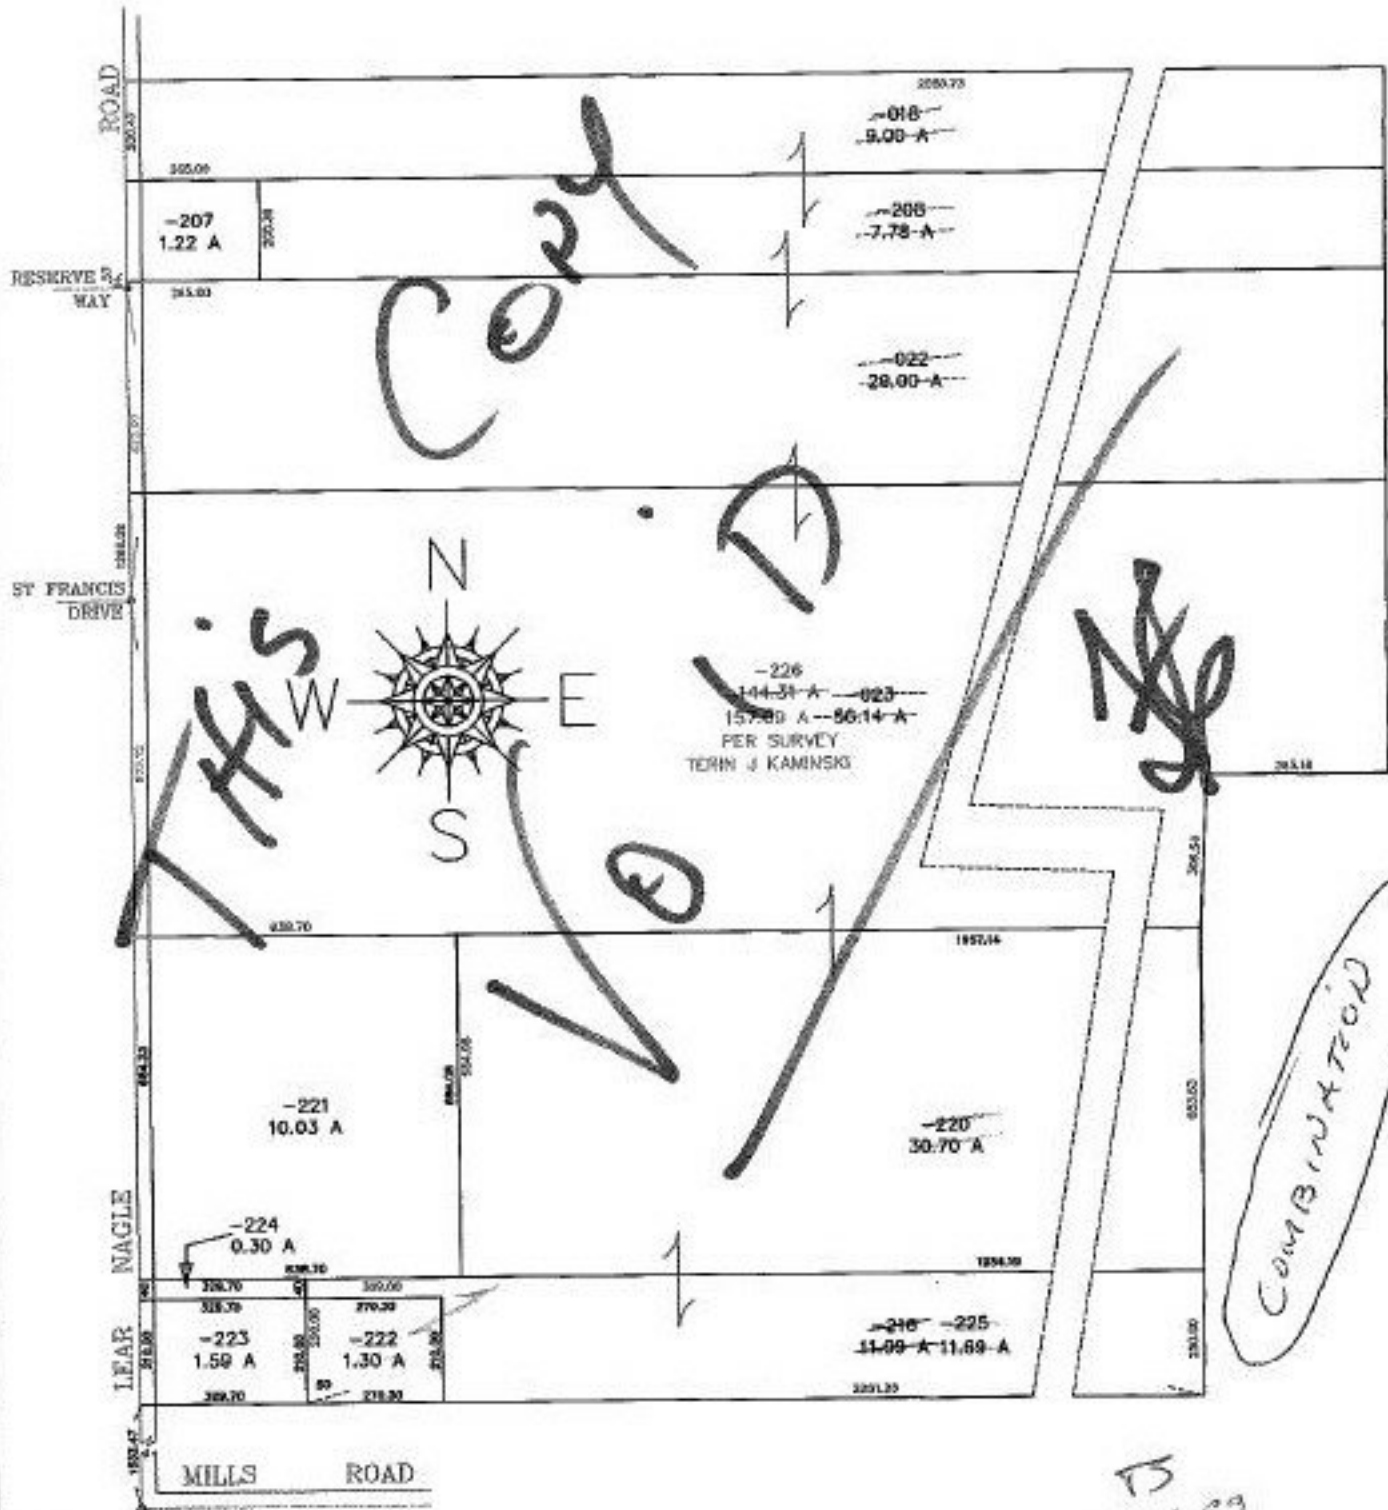

TS
2-18-99

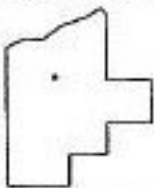

SPLITS/DEEDS PROCESSED
LORAIN COUNTY TAX MAP DEPARTMENT
226 MIDDLE AVE. ELYRIA, OHIO

SURVEYED BY: TERIN J KAMINSKI
CLOSURE: 0.00 / 10.000
MAP PAGE(S): 4-00-025-A.E.F 4-1
APPROVED BY: F. COLBERT DATE: 12/16/98
SCALE: 1" = 400' PRIOR INSTRUMENT: DV XXXX/XXX