
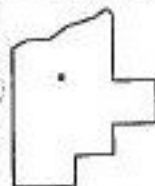


PARENT PARCEL: 03-00-062-000-001

CHILD PARCEL: 03-00-062-000-010 THRU -013

STARTING POINT: PK. NAIL, CL OF LAKE BREEZE RD. & NORTH LINE OF O.L. 62

NO. 22736

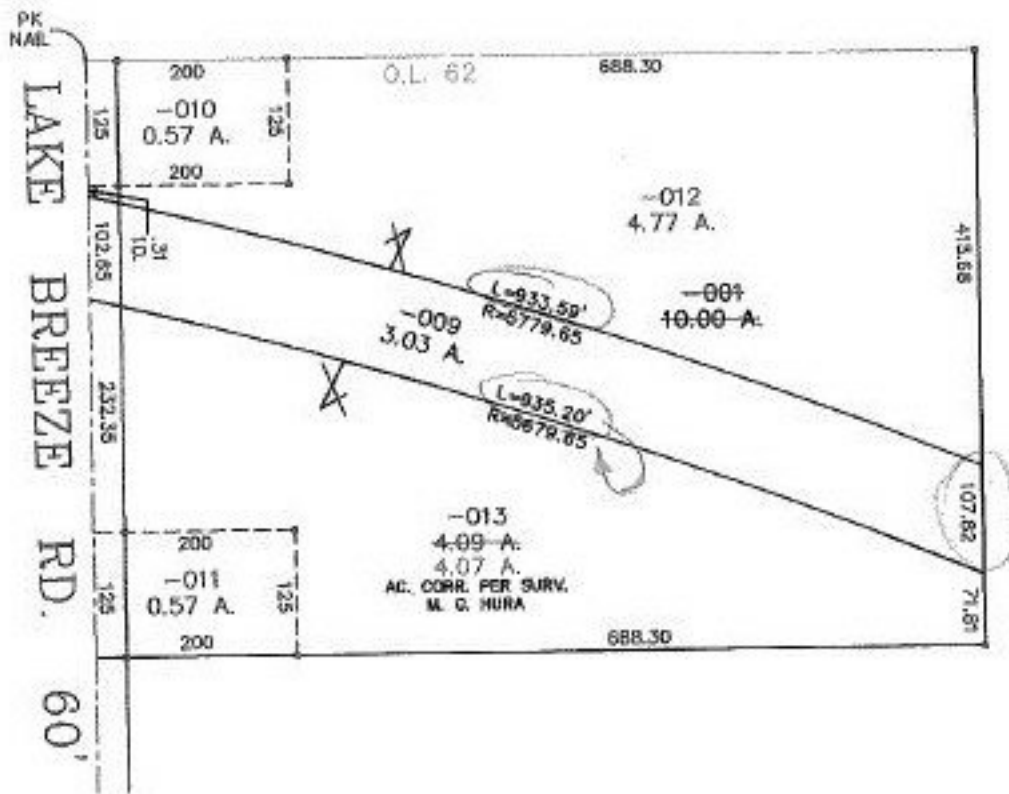

SPLITS/DEEDS PROCESSED
LORAIN COUNTY TAX MAP DEPARTMENT
 226 MIDDLE AVE. ELYRIA, OHIO

SURVEYED BY: M. G. HURA
 CLOSURE: 0.00 : 10.000
 MAP PAGE(S): 03-00-062
 APPROVED BY: TJS DATE: 02/17/99
 SCALE: 1" = 200' PRIOR INSTRUMENT: OR 1015/387