


#22739

NO. 22739

PARENT PARCEL: 04-00-008-104-083  
CHILD PARCEL: 04-00-008-104-097 THRU -099  
STARTING POINT: MON. BOX, CL. OF PIN OAK PKWY. STA. 10+20.00

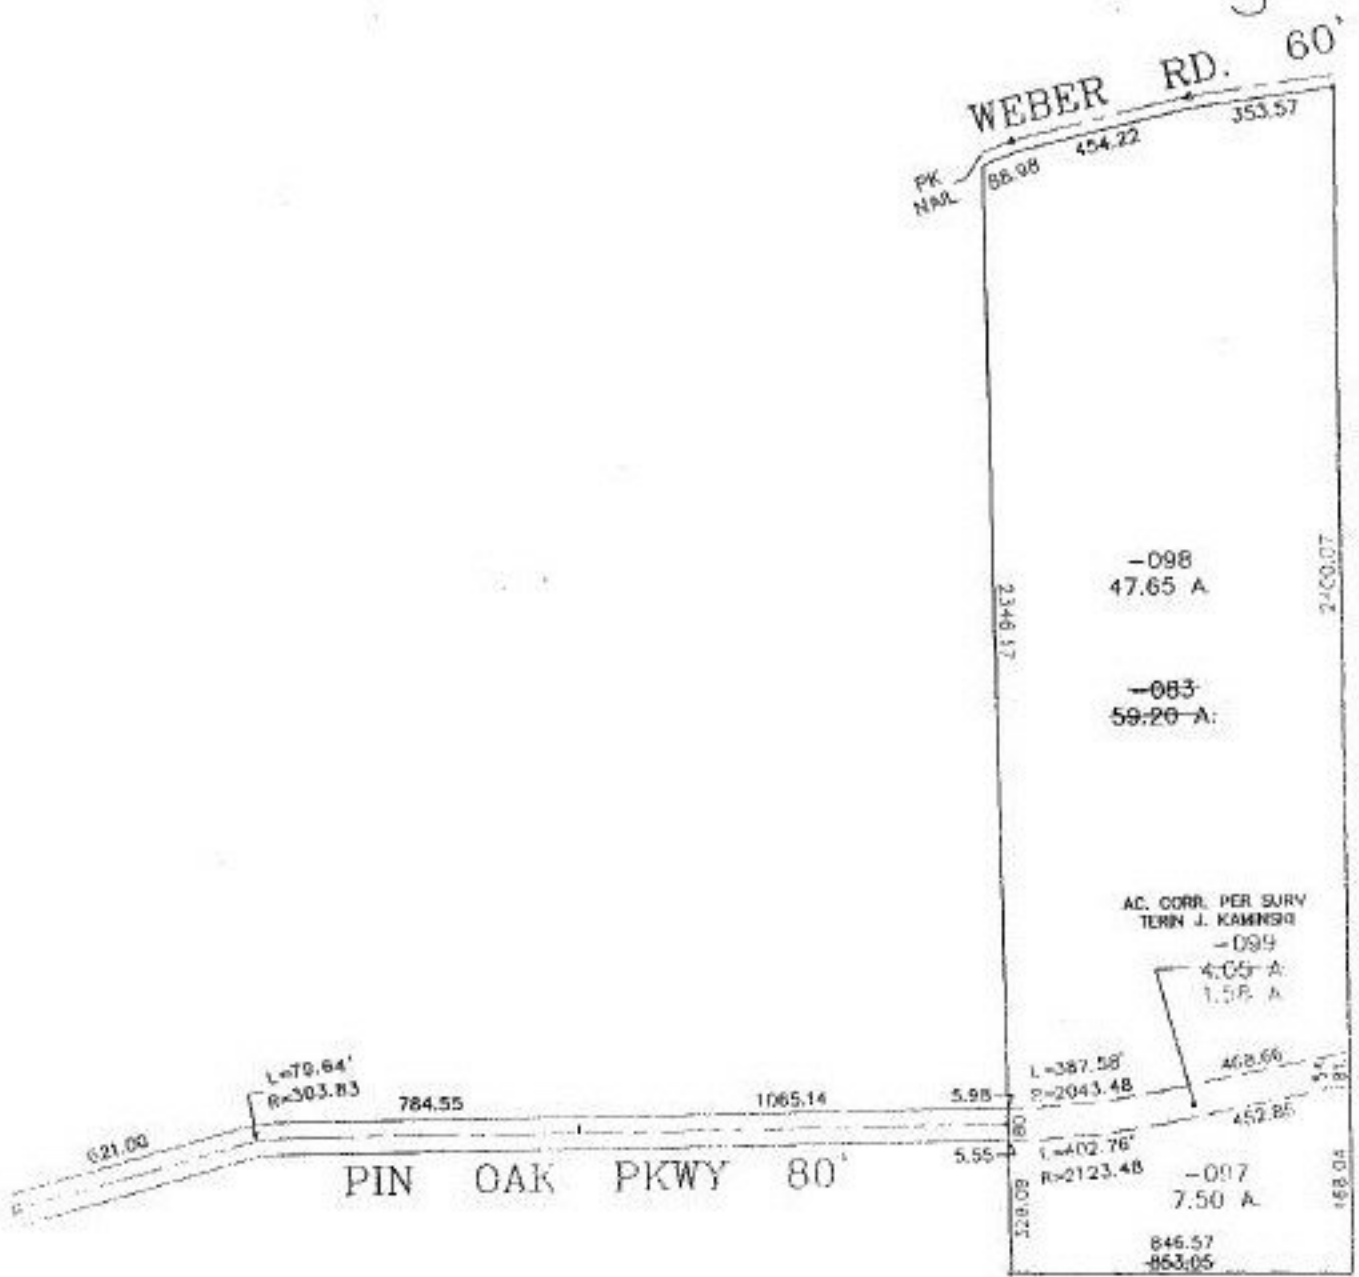

**SPLITS/DEEDS PROCESSED**  
LORAIN COUNTY TAX MAP DEPARTMENT  
226 MIDDLE AVE. ELYRIA, OHIO

SURVEYED BY: TERRIN J. KAMINSKI  
CLOSURE: 0.08 : 10.000  
MAP PAGE(S): 4-8  
APPROVED BY: IJS DATE: 02/11/99  
SCALE: 1" = 500 PRIOR INSTRUMENT: DV 768/649