
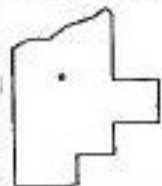


PARENT PARCEL: 04-00-008-104-083

CHILD PARCEL: 04-00-008-104-097 THRU -099

STARTING POINT: MON. BOX, CL OF PIN OAK PKWY. STA. 10+20.00

NO. 22739

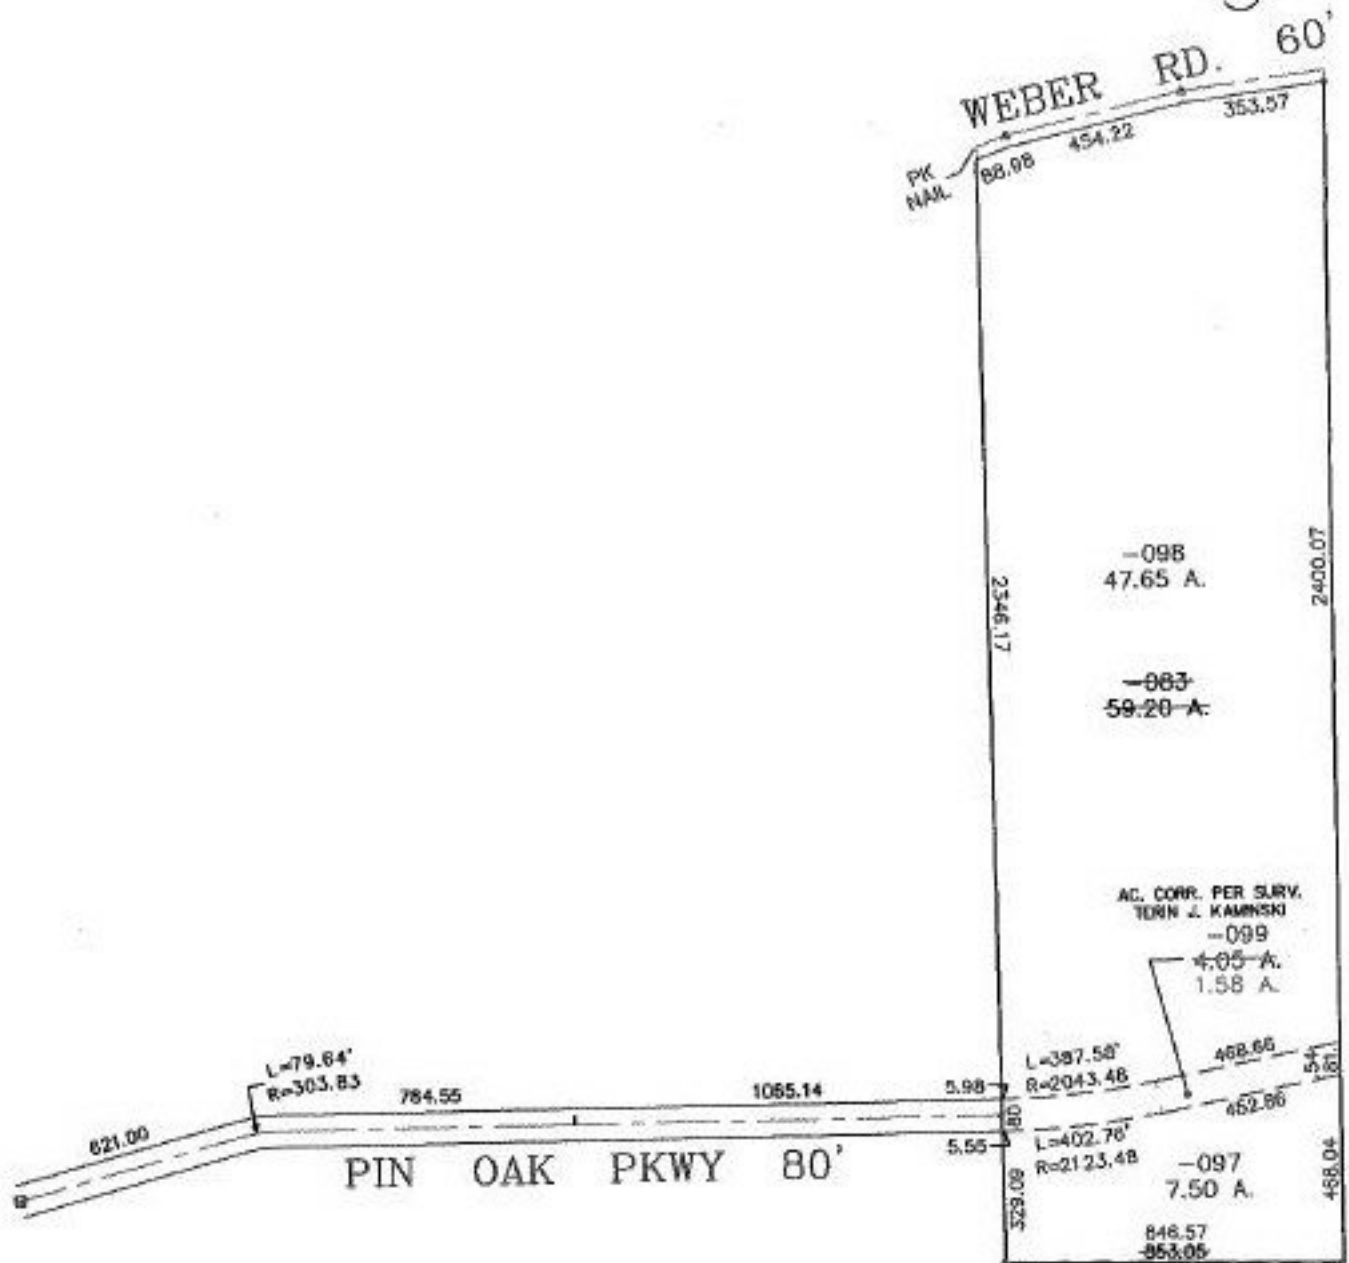

SPLITS/DEEDS PROCESSED
 LORAIN COUNTY TAX MAP DEPARTMENT
 228 MIDDLE AVE. ELYRIA, OHIO

SURVEYED BY: TERIN J. KAMINSKI
 CLOSURE: 0.08 : 10.00
 MAP PAGE(S): 4-B
 APPROVED BY: IJS DATE: 02/11/99
 SCALE: 1" = 500' PRIOR INSTRUMENT: DV 768/649