

166	166	166	166
88	88	88	88
86 - 010	85 - 011	84 - 012	102 - 019
62.5	62.5	68	170.27
62.5	62.5	68	59.69

31 - 016	19 - 035
30 - 017	20 - 036
29 - 018	21 - 037
28 - 019	22 - 038

78 - 002	80 - 003	81 - 005	82 - 006	83 - 007
62.5	62.5	62.5	62.5	62.5
60	60	60	60	60

PEARL

27 - 008	26 - 009	25 - 010	24 - 011	23 - 012
66.5	62.5	62.5	62.5	66.5
66.5	62.5	62.5	62.5	66.5

BLVD. 60

104

1450.18

APPROVED
LORAIN CO.
MAP DEPT.
DATE 11/21/18
BY 9-00-003-A


S.D. 7-25-86

2274

(Handwritten signature)

013
5.66 A.

20

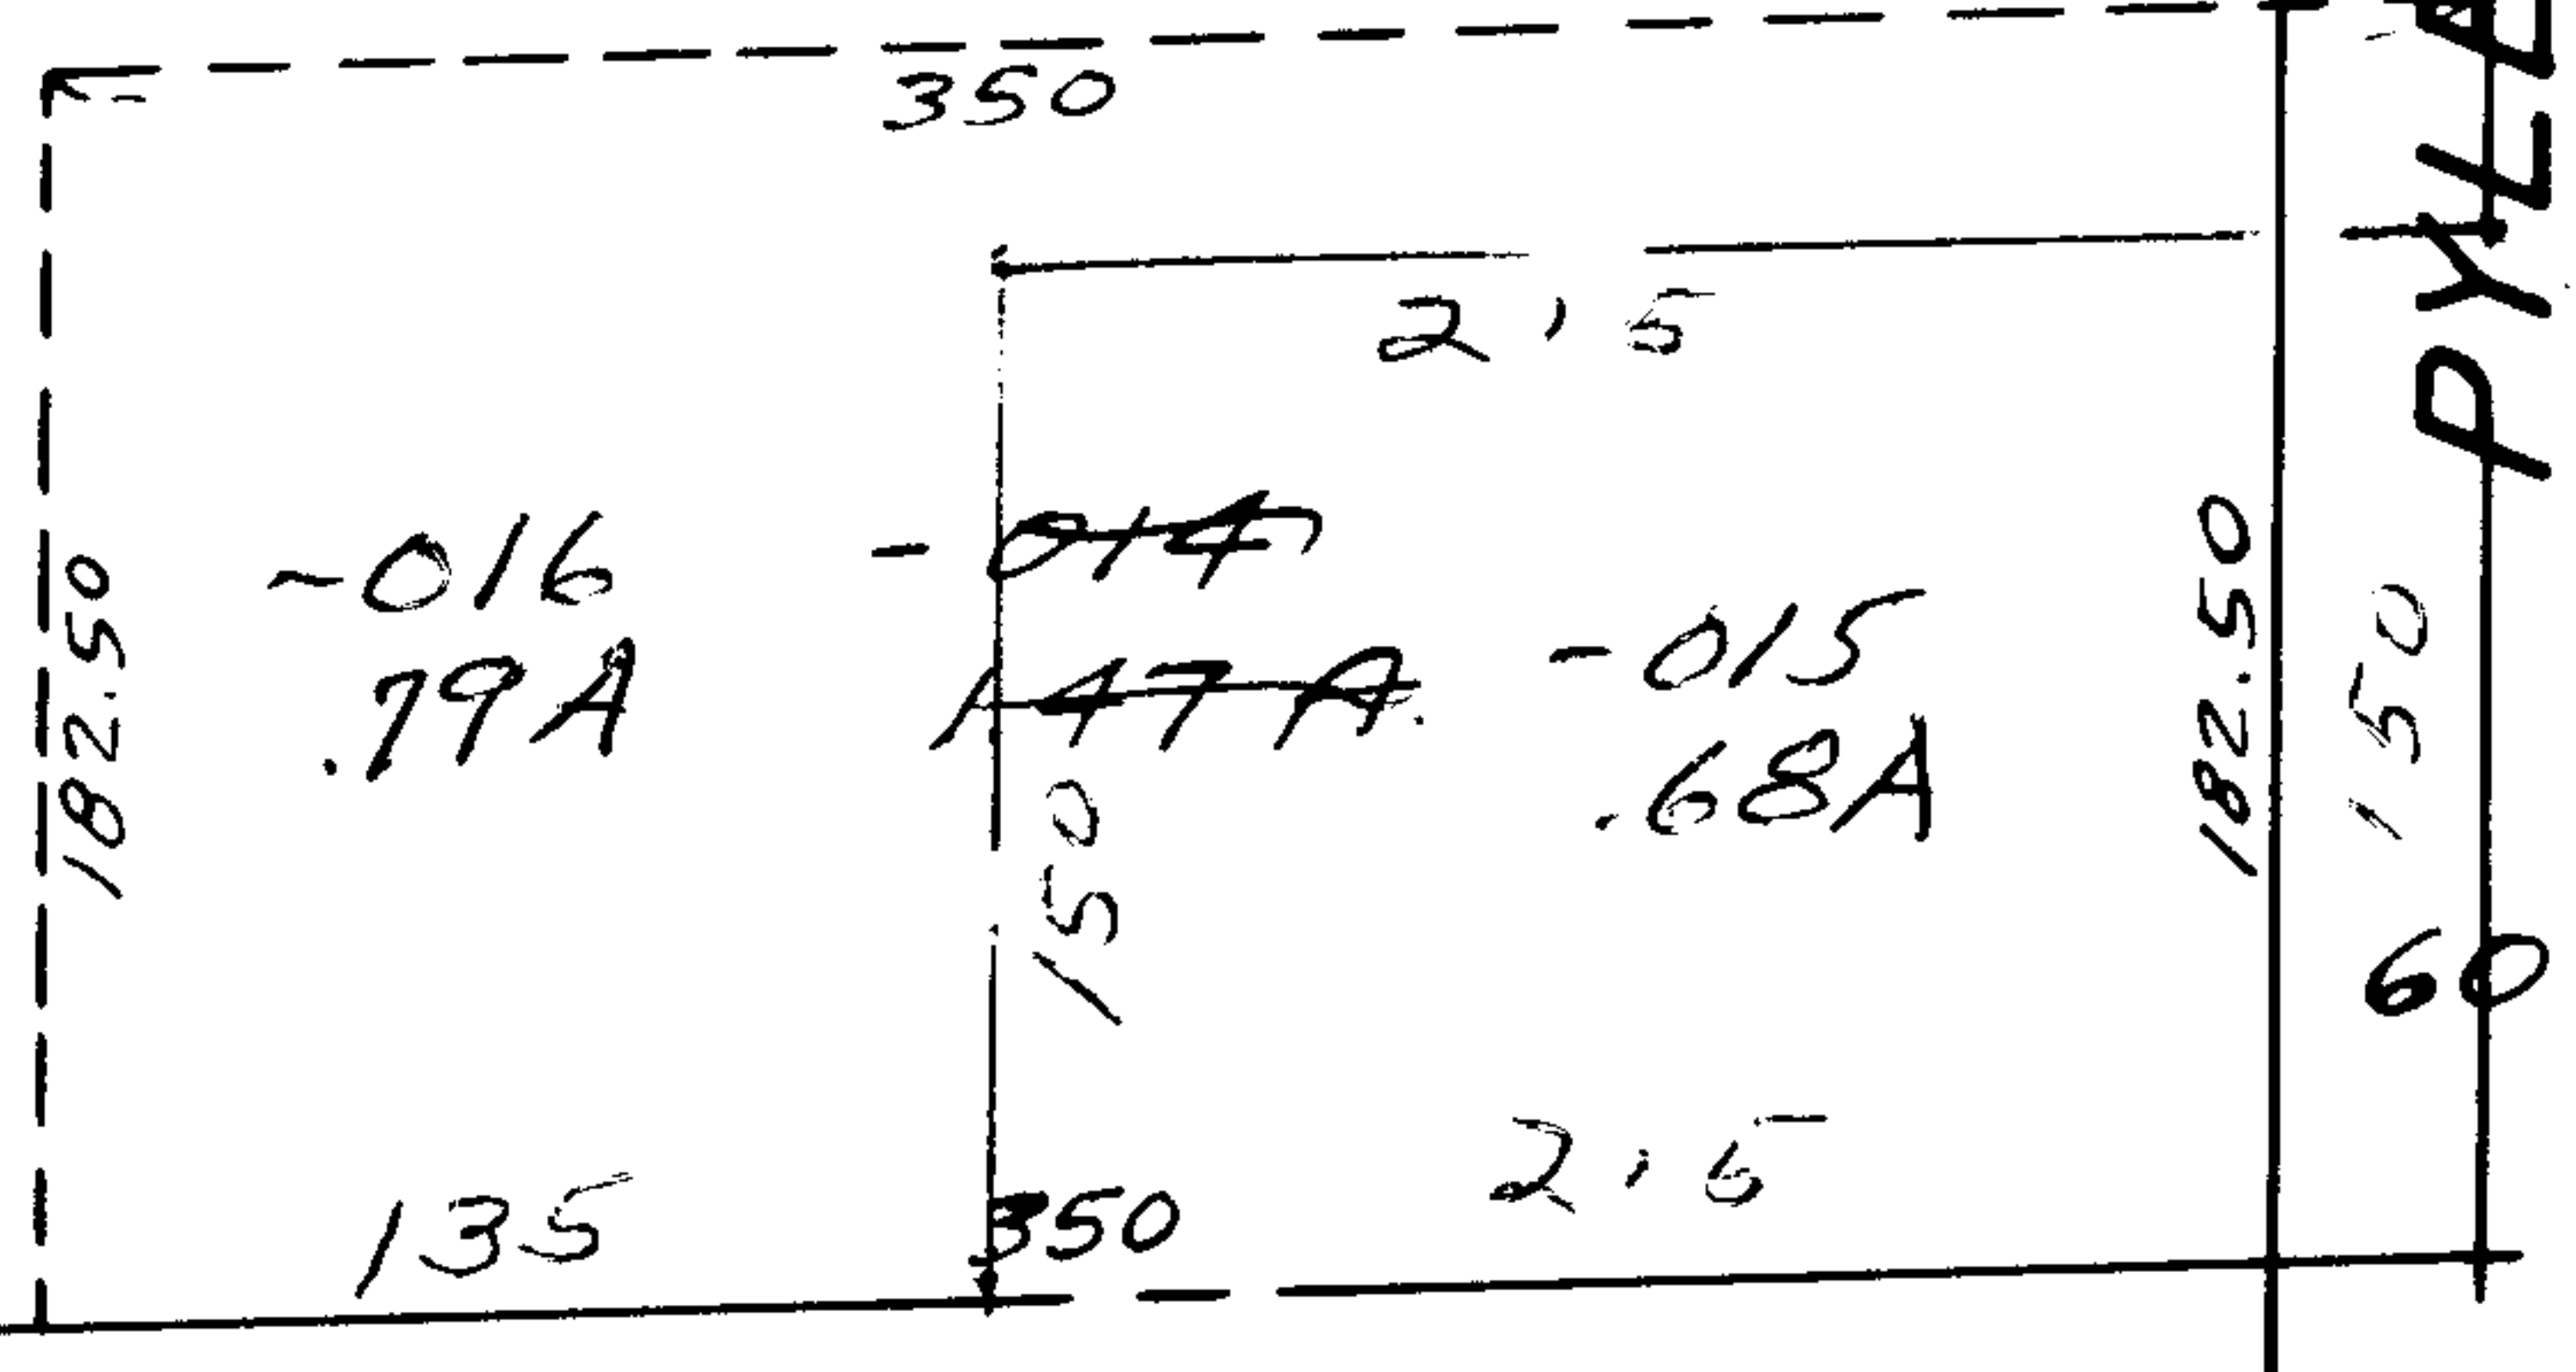

60 PYLE - SOUTH AMHERST



013 - A

350
215
135