



PARENT PARCEL: 05-00-004-101-001 & -003, 05-00-004-500-001
 CHILD PARCEL: 05-00-004-101-004 THRU -009
 STARTING POINT: MON. BOX. CL. OF QUARRY RD. & THE SOUTHERLY LINE OF O.L. 97

NO. 22744

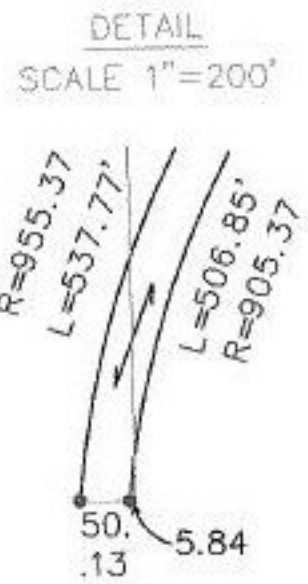

PRIOR INSTRUMENT: DV 1411/604
 PRIOR INSTRUMENT: OR 204/25

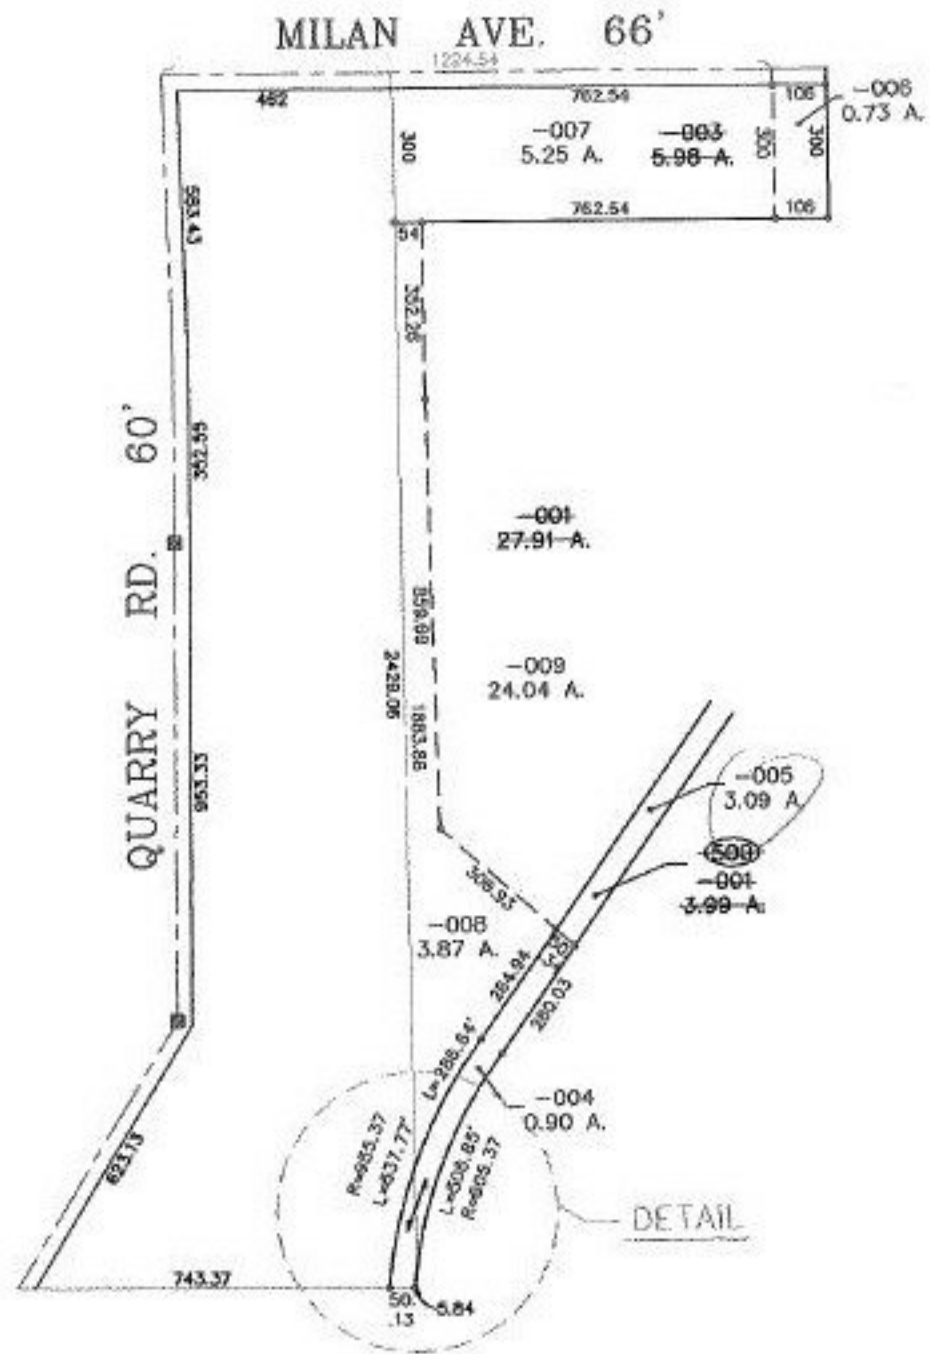

SPLITS/DEEDS PROCESSED
 LORAIN COUNTY TAX MAP DEPARTMENT
 226 MIDDLE AVE. ELYRIA, OHIO

SURVEYED BY: MICHAEL A. STRAUB
 CLOSURE: 0.11 : 10.000
 MAP PAGE(S): 05-00-004-A
 APPROVED BY: TJS DATE: 01/15/99
 SCALE: 1"= 400 PRIOR INSTRUMENT: DV XXXX/XXX