

PARENT PARCEL: 11-00-048-000-025 & -026

CHILD PARCEL: XXXXXXXXXXXX

STARTING POINT: CL OF WOOSTER-AVON LAKE RD. & N.W. CORNER OF CESSNA HOMES SUB.

NO. 22749-D


# DEED CHECK




PARCEL 1: 11-00-048-000-025 OK  
0.09 A.

PARCEL 2: 11-00-048-000-026 OK  
33.64 A.

UPDATE LEGAL BEFORE NEXT TRANSFER

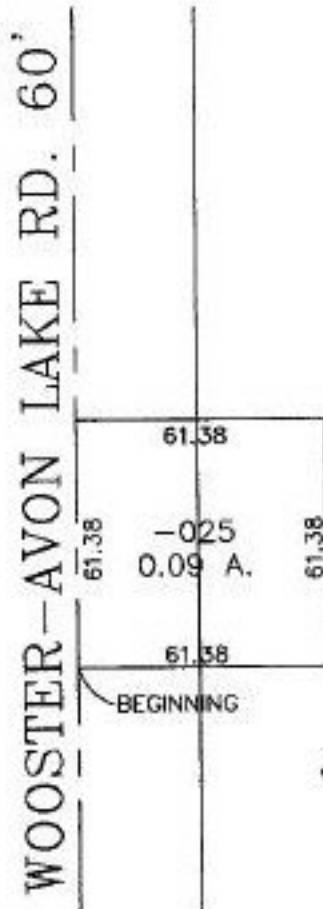

**NO CHANGES  
OF TAX MAP**

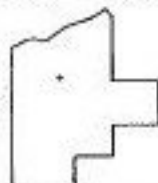

**SPLITS/DEEDS PROCESSED**  
LORAIN COUNTY TAX MAP DEPARTMENT  
226 MIDDLE AVE. ELYRIA, OHIO

SURVEYED BY: McGLINCHY & ASSOC.  
CLOSURE: #1) 0.00 : 10.000 & #2) CAN'T RUN  
MAP PAGE(S): 11-00-048-A & 11-00-049-A  
APPROVED BY: TJS DATE: 01/19/99  
SCALE: 1" = 50' PRIOR INSTRUMENT: DV 1186/221