
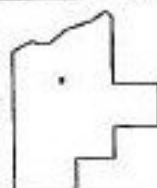


PARENT PARCEL: 15-00-033-000-007

CHILD PARCEL: 15-00-033-000-015 & -016

STARTING POINT: CL OF WHEELER RD. & SOUTH LINE OF O.L. 33

NO. 22752

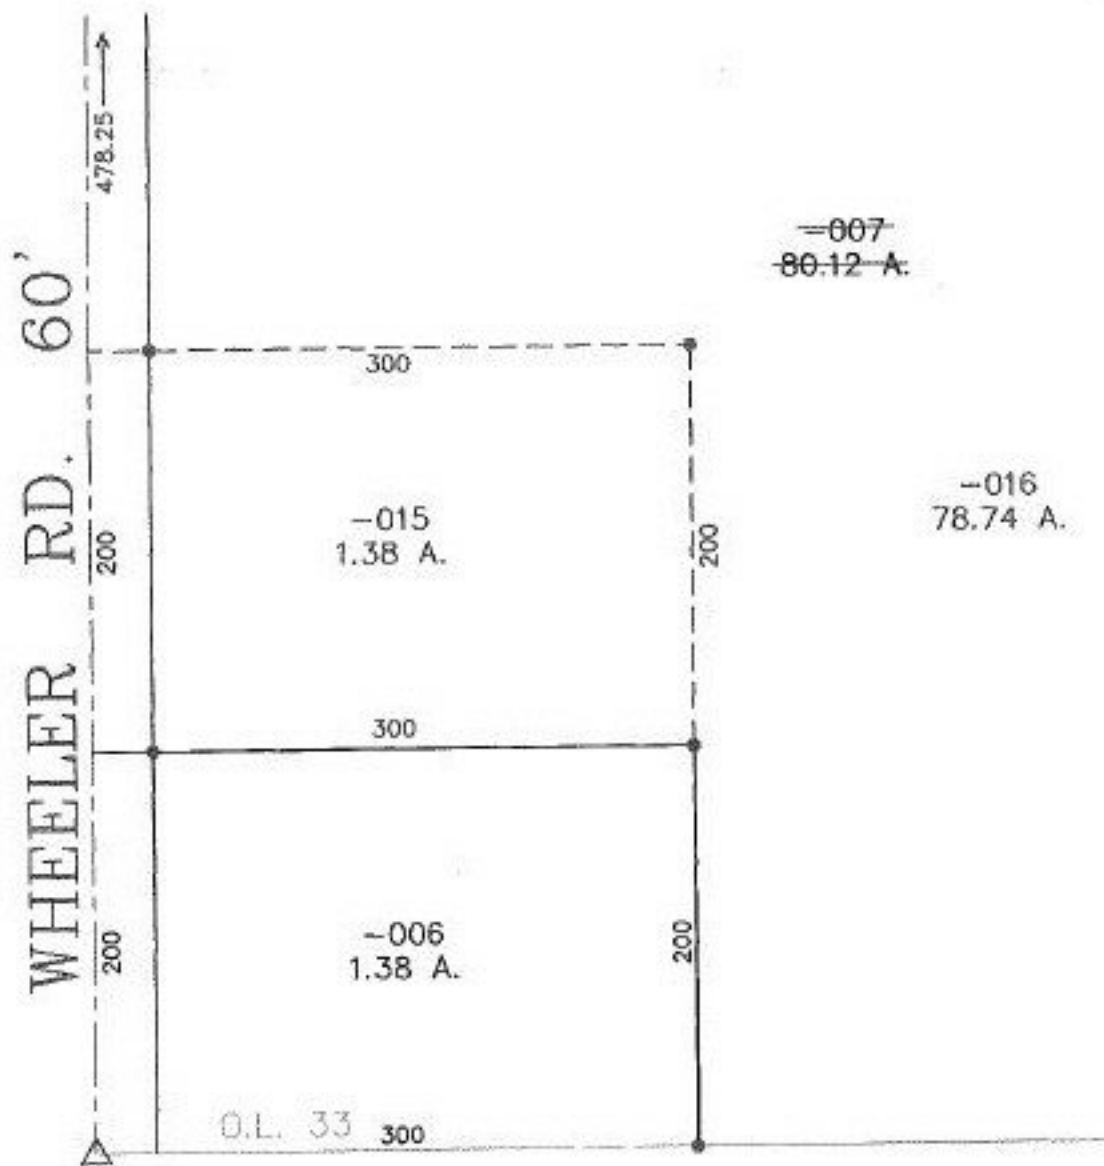

SPLITS/DEEDS PROCESSED

LORAIN COUNTY TAX MAP DEPARTMENT
226 MIDDLE AVE. ELYRIA, OHIO

SURVEYED BY: DOUGLAS H. MOSLEY

CLOSURE: 0.00 : 10,000

MAP PAGE(S): 15-D

APPROVED BY: TJS DATE: 01/19/99

SCALE: 1" = 100' PRIOR INSTRUMENT: DV 1395/766