
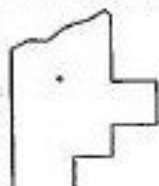


PARENT PARCEL: 08-00-091-000-033

CHILD PARCEL: 08-00-091-000-061 & -062

STARTING POINT: R.R.S., CL. OF GIFFORD RD. & CL. OF MILAN-ELYRIA RD.

NO. 22754

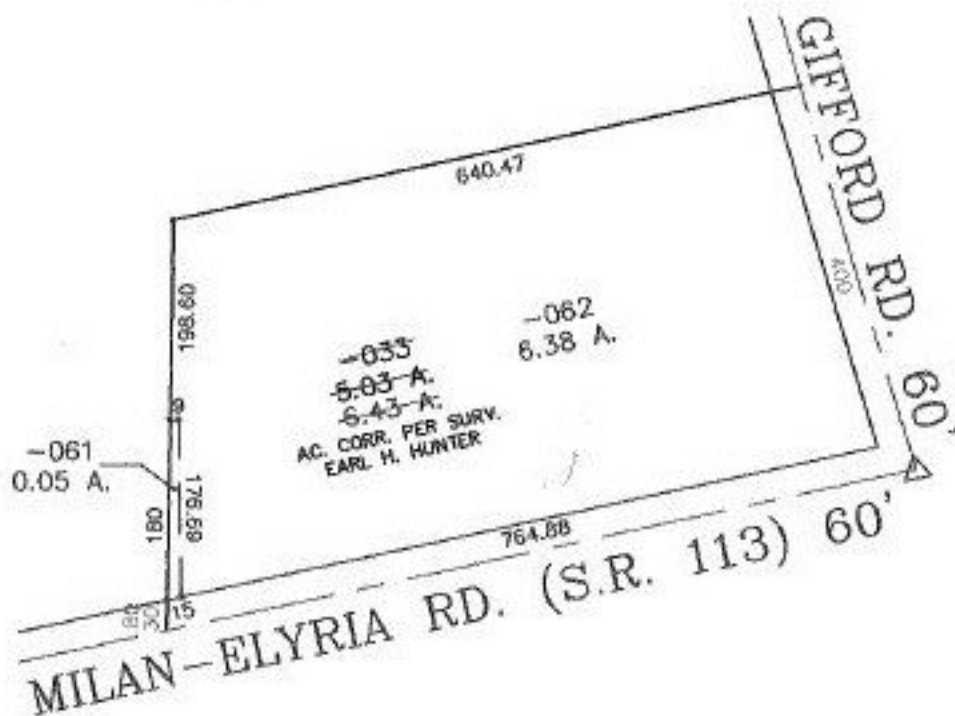

SPLITS/DEEDS PROCESSED
 LORAIN COUNTY TAX MAP DEPARTMENT
 226 MIDDLE AVE. ELYRIA, OHIO

SURVEYED BY: EARL H. HUNTER
 CLOSURE: 0.02 : 10,000
 MAP PAGE(S): 8-C
 APPROVED BY: TJS DATE: 03/04/99
 SCALE: 1" = 200' PRIOR INSTRUMENT: OR 47/690