

PARENT PARCEL: 04-00-014-107-002, -008, -009, & -013, 04-00-014-106-007 THRU -010
 CHILD PARCEL: 04-00-014-107-176 THRU -181
 STARTING POINT: DEED #1: I.P. IN THE S.E. CORNER OF S\1 10, IN THE JOHN GRITNER PLAT
 DEED #2: I.P. IN THE N.E. CORNER OF S\1 10, IN THE JOHN GRITNER PLAT
 DEED #3: I.P. IN THE N.E. CORNER OF S\1 10, IN THE JOHN GRITNER PLAT
 DEED #4: I.P. IN THE S.E. CORNER OF S\1 5, IN THE JOHN GRITNER PLAT


NO. 22760



JOHN GRITNER PLAT
 V. 11 PG. 20

AC. CORR. PER SURV.
 RICHARD ROSEBECK

WOOSTER-AVON LAKE RD. 60'

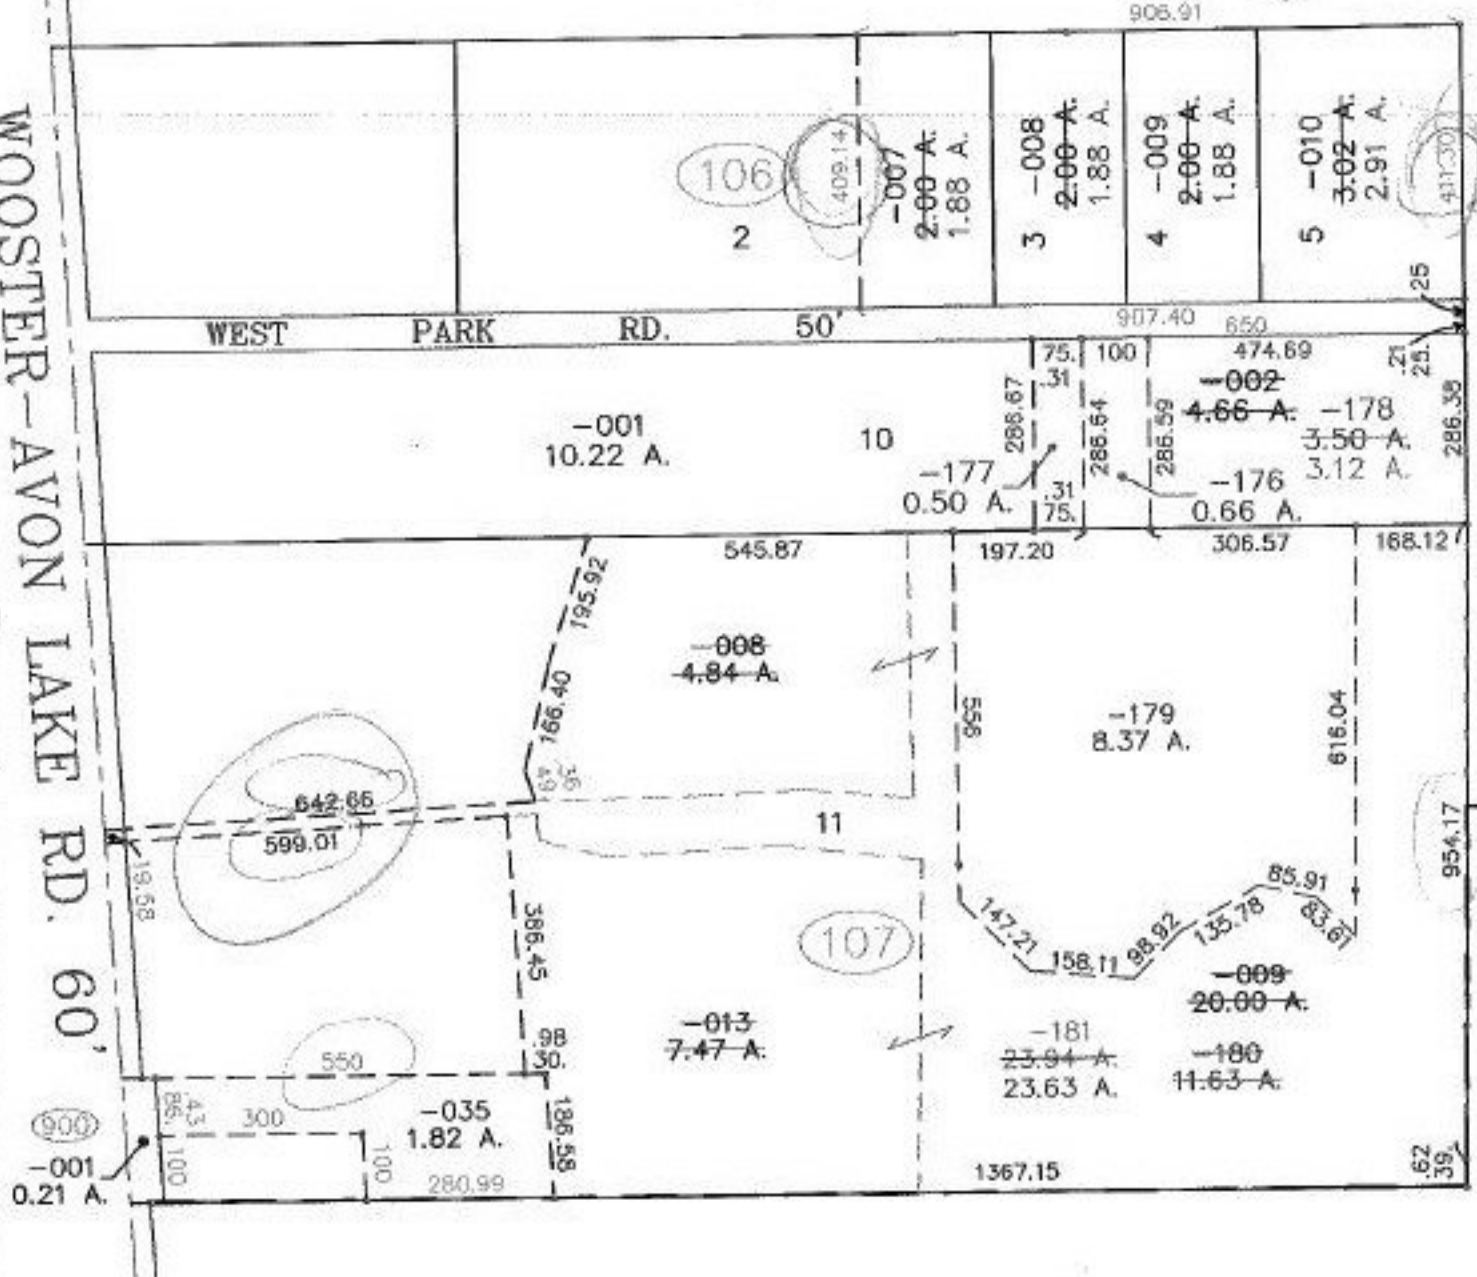

SPLITS/DEEDS PROCESSED
 LORAIN COUNTY TAX MAP DEPARTMENT
 226 MIDDLE AVE. ELYRIA, OHIO

SURVEYED BY: RICHARD ROSEBECK
 CLOSURE: 0.35 : 10,000
 MAP PAGE(S): 04-00-014-C
 APPROVED BY: TJS DATE: 03/03/99
 SCALE: 1" = 300' PRIOR INSTRUMENT: 970489623