


2054

2294

SEE 7-00-024-A

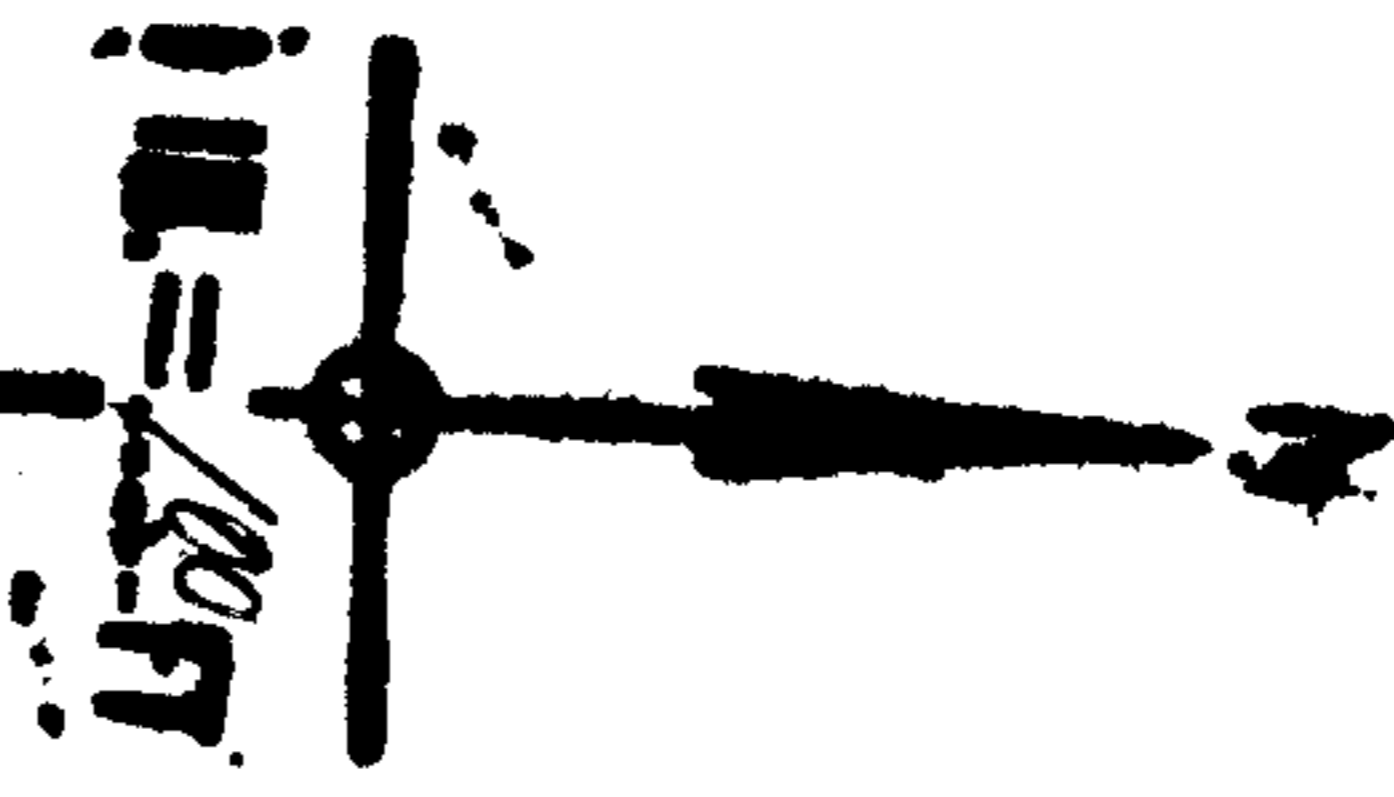


APPROVED
LORAIN CO.
MAP DEPT.
DATE 8-23-68
BY [Signature]

Stamp area containing approval details, date (8-23-68), and signature.

8191968

818 98-11-L

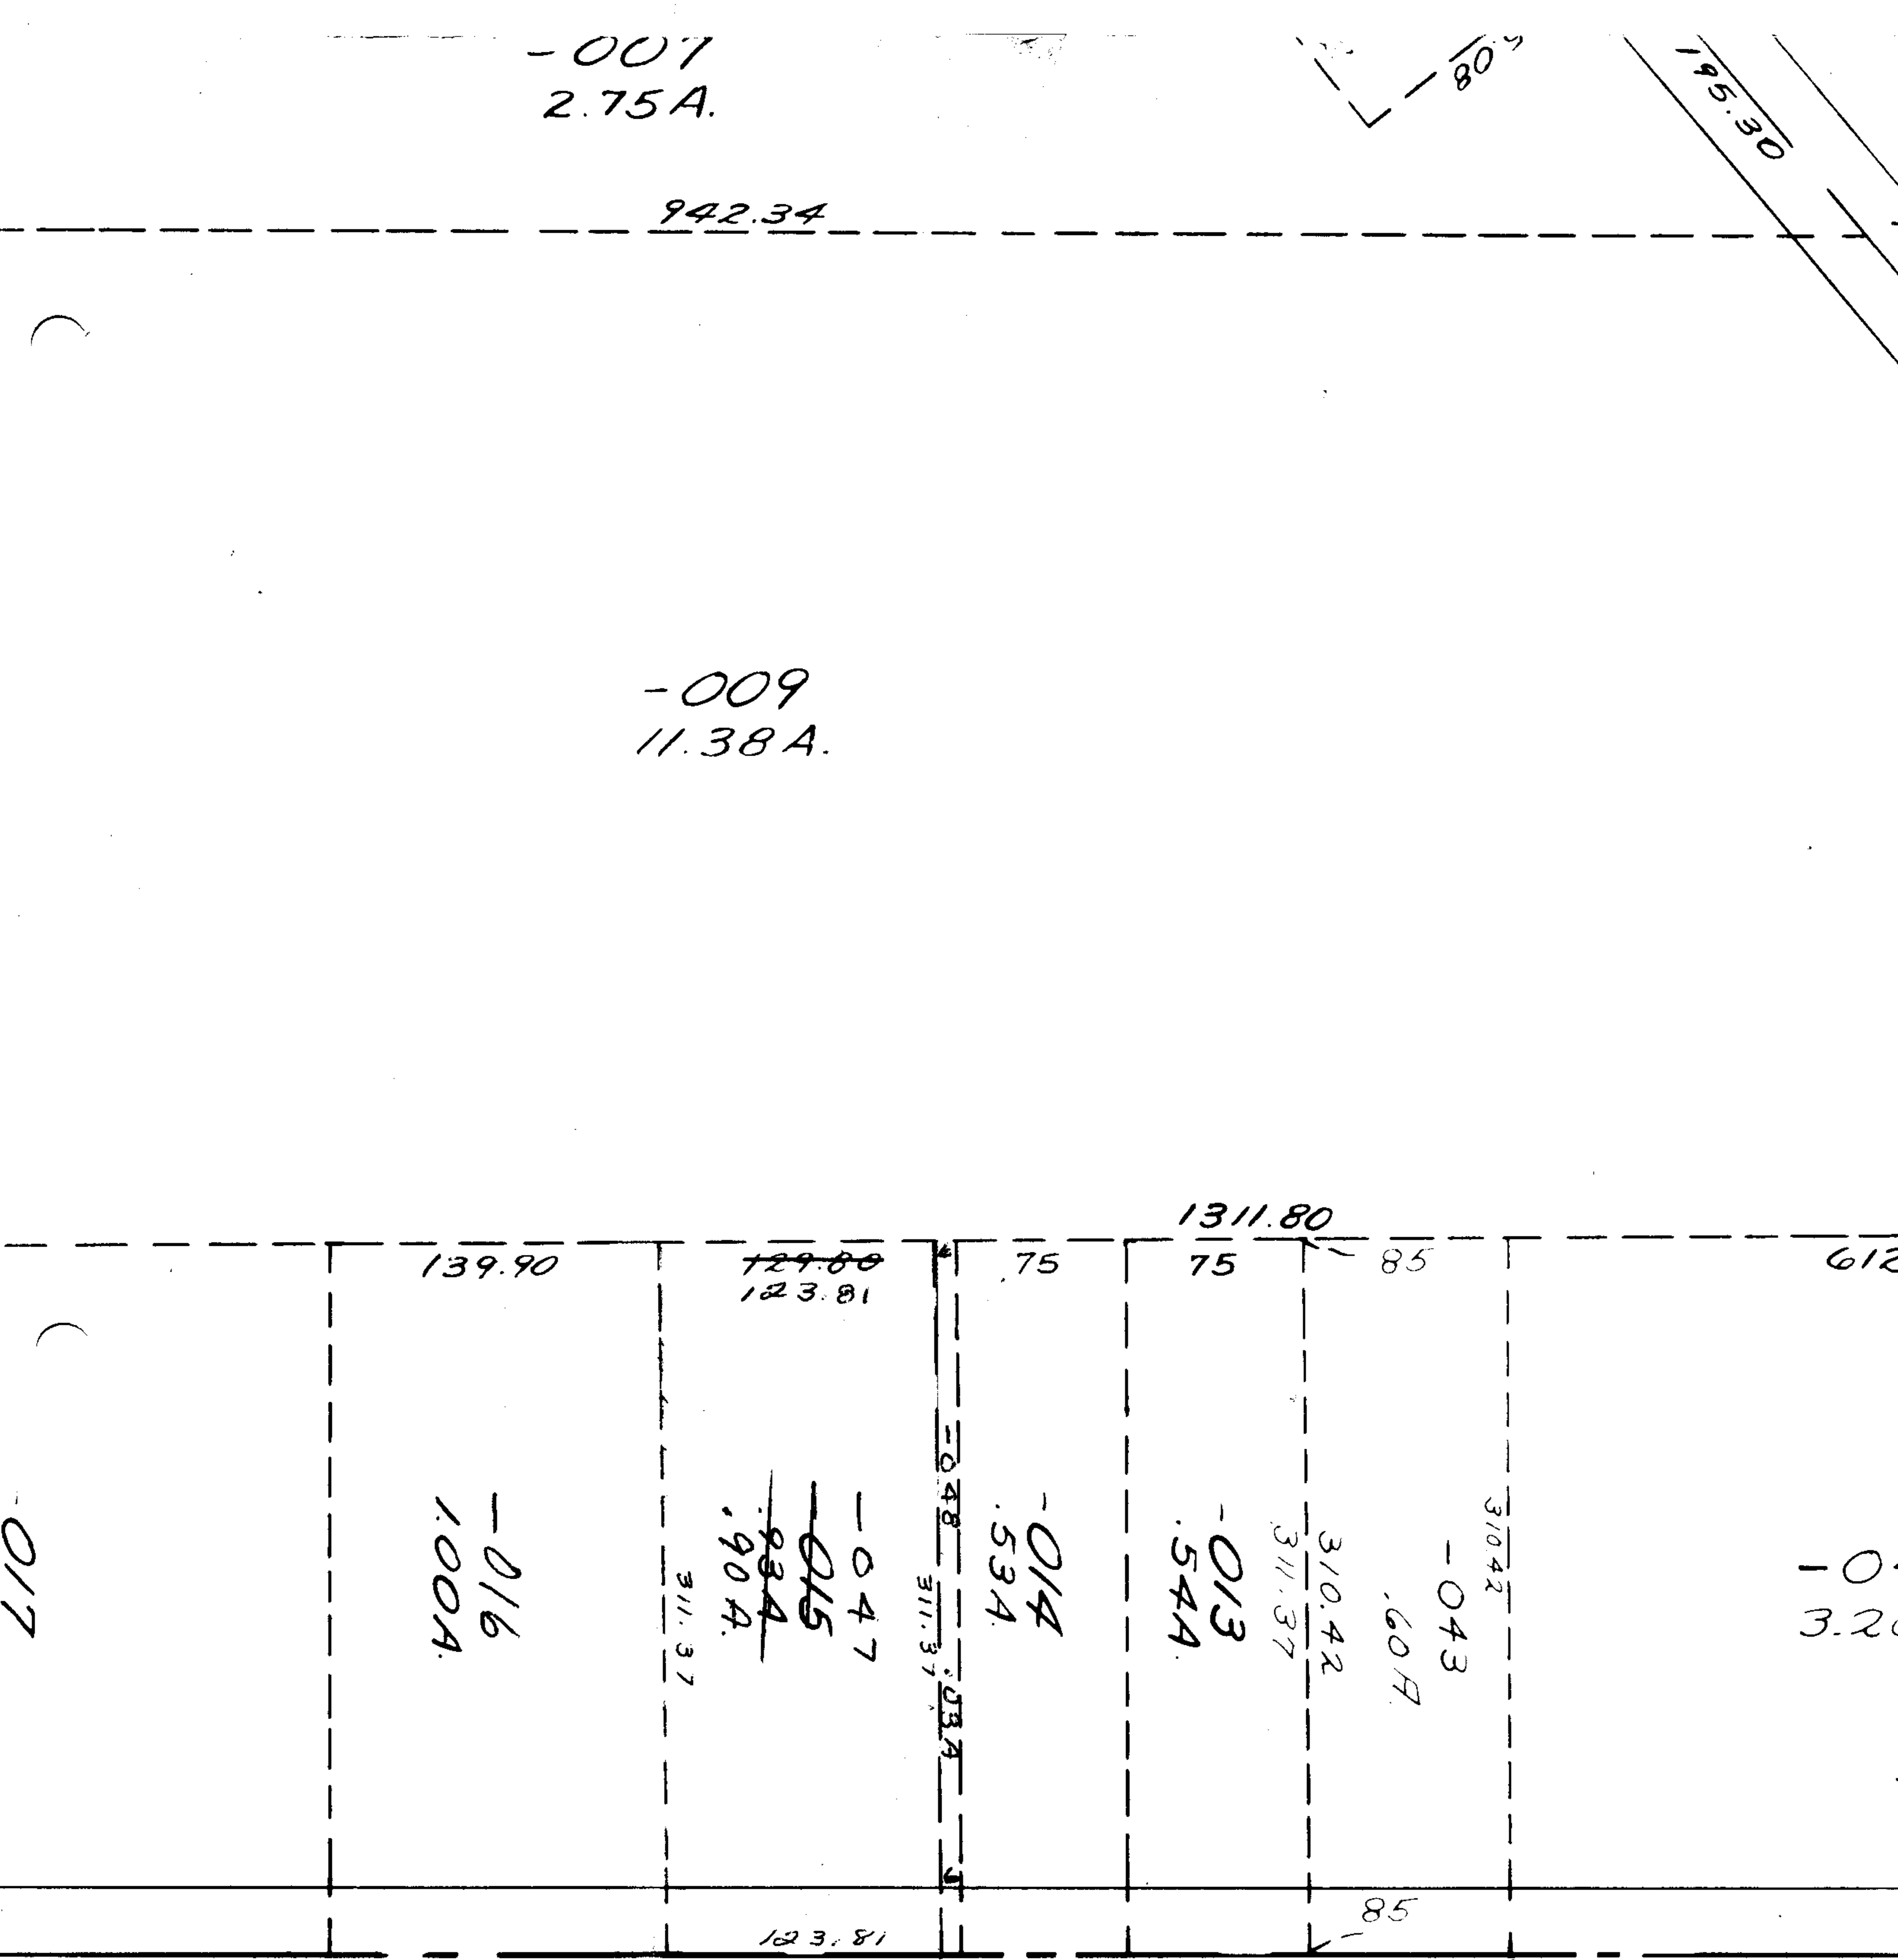

612
-04
3.26

310.42

-043

.60 A.

310.42

311.37

-013

.54 A.

-014

.53 A.

-048

311.37

-047

-015

~~934~~

.90 A.

311.37

-016
1.00 A.

139.90

~~129.80~~
123.81

75

75

85

612

1311.80

-009
11.38 A.

942.34

-007
2.75 A.

80

195.30

-017