
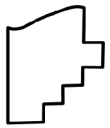


PARENT PARCEL: ADD TO DUPLICATE - PER ORD. 137-23
CHILD PARCEL: 02-01-005-112-014
STARTING POINT: VACATION OF CORNELL PLACE 40' FROM W. 6TH ST. TO 6TH COURT

23-05131-V

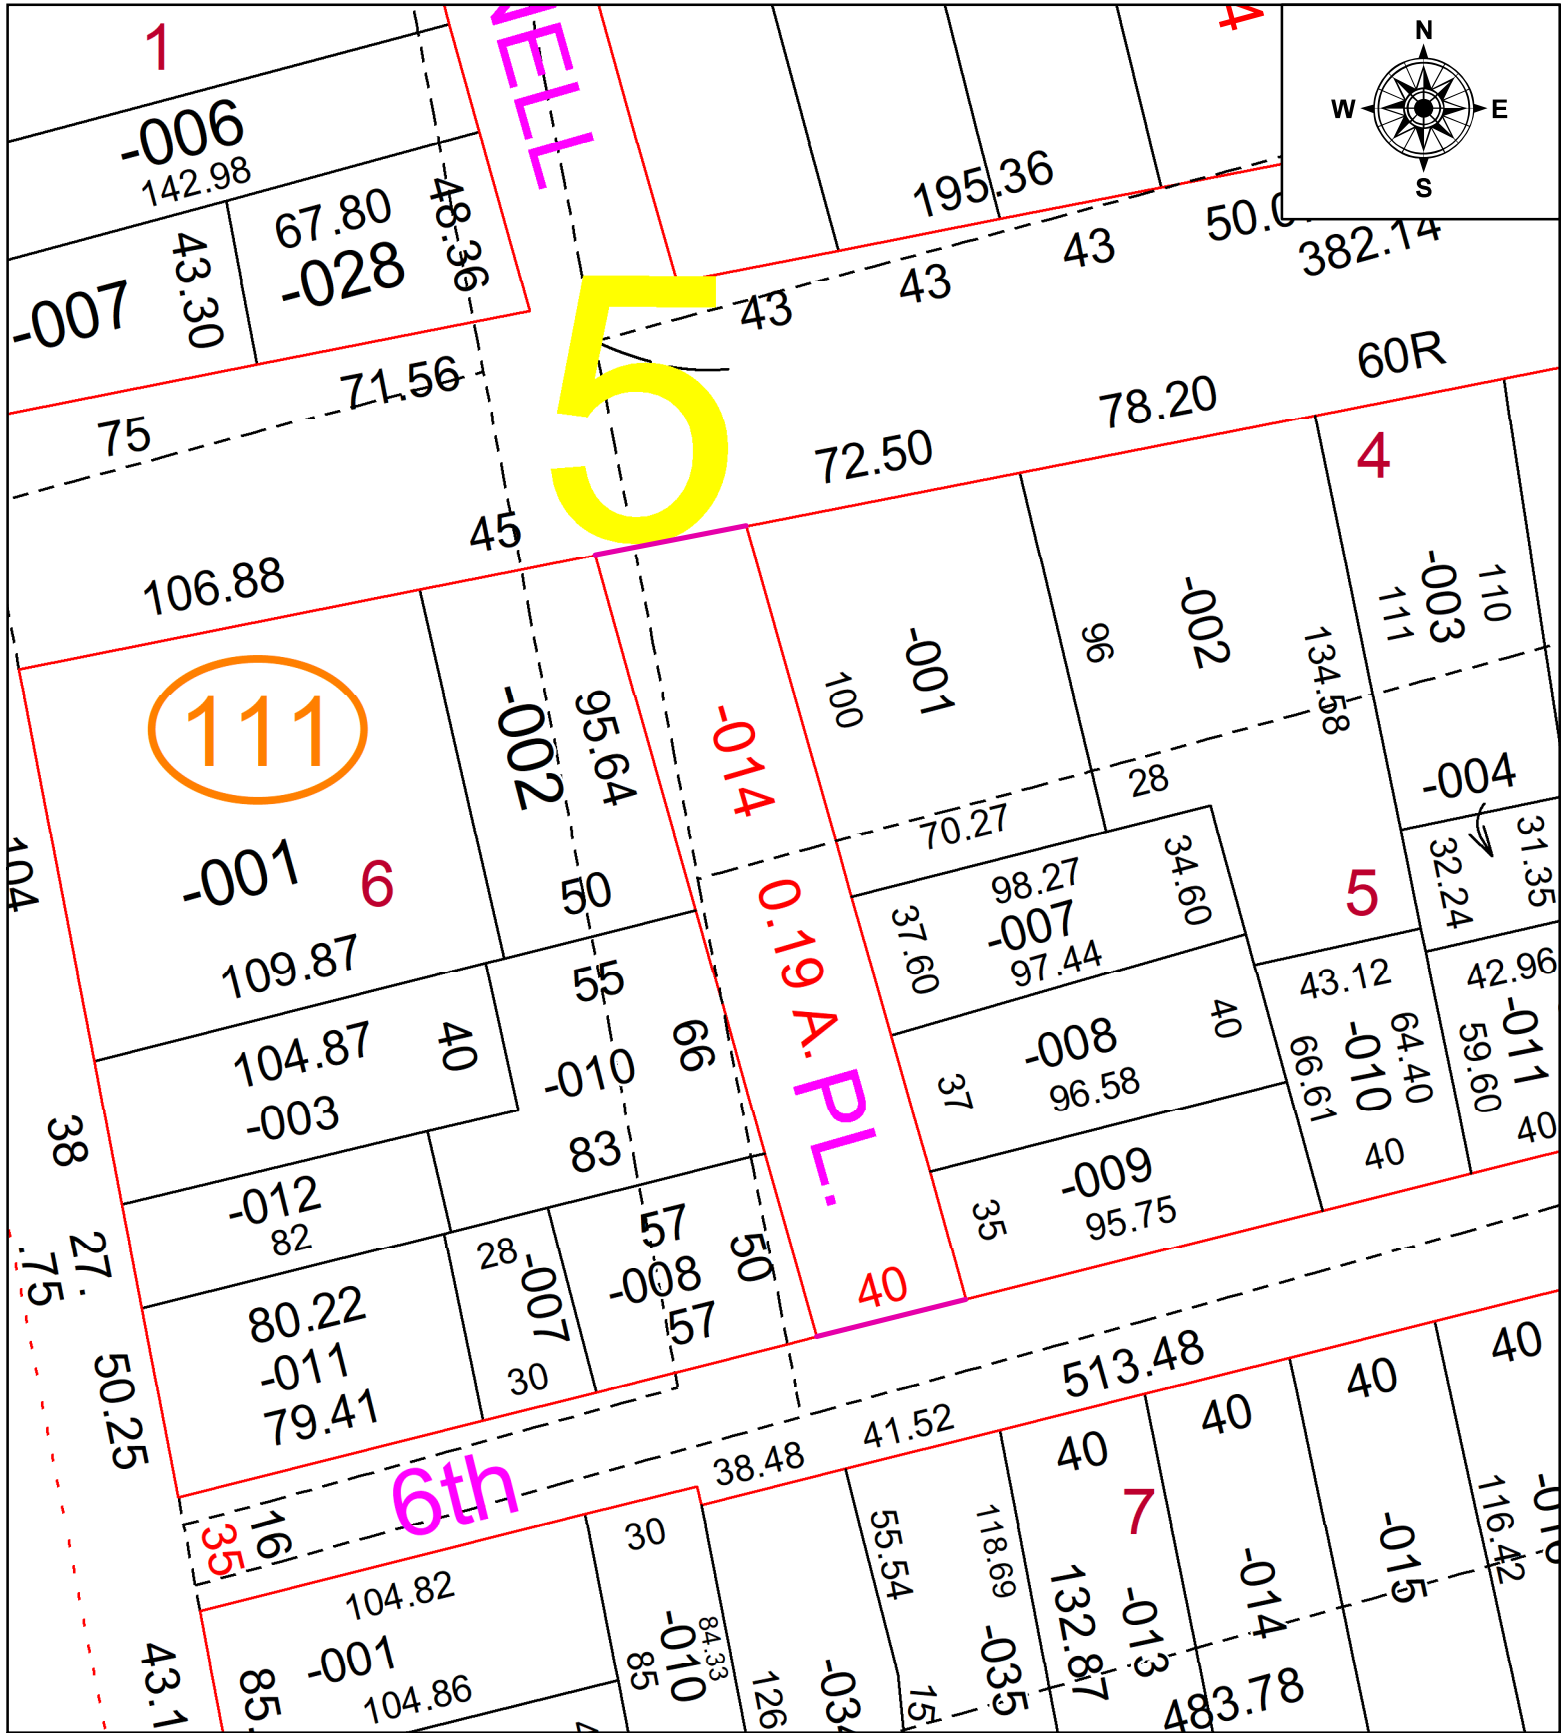

SPLITS/DEEDS PROCESSED
LORAIN COUNTY TAX MAP DEPARTMENT
226 MIDDLE AVE. ELYRIA, OH

SURVEYED BY: NA
CLOSURE: NA
MAP PAGE(S): 02-01-005
APPROVED BY: TJS DATE: 8/14/2023
SCALE: 1" = 50' PRIOR INSTRUMENT: NA