

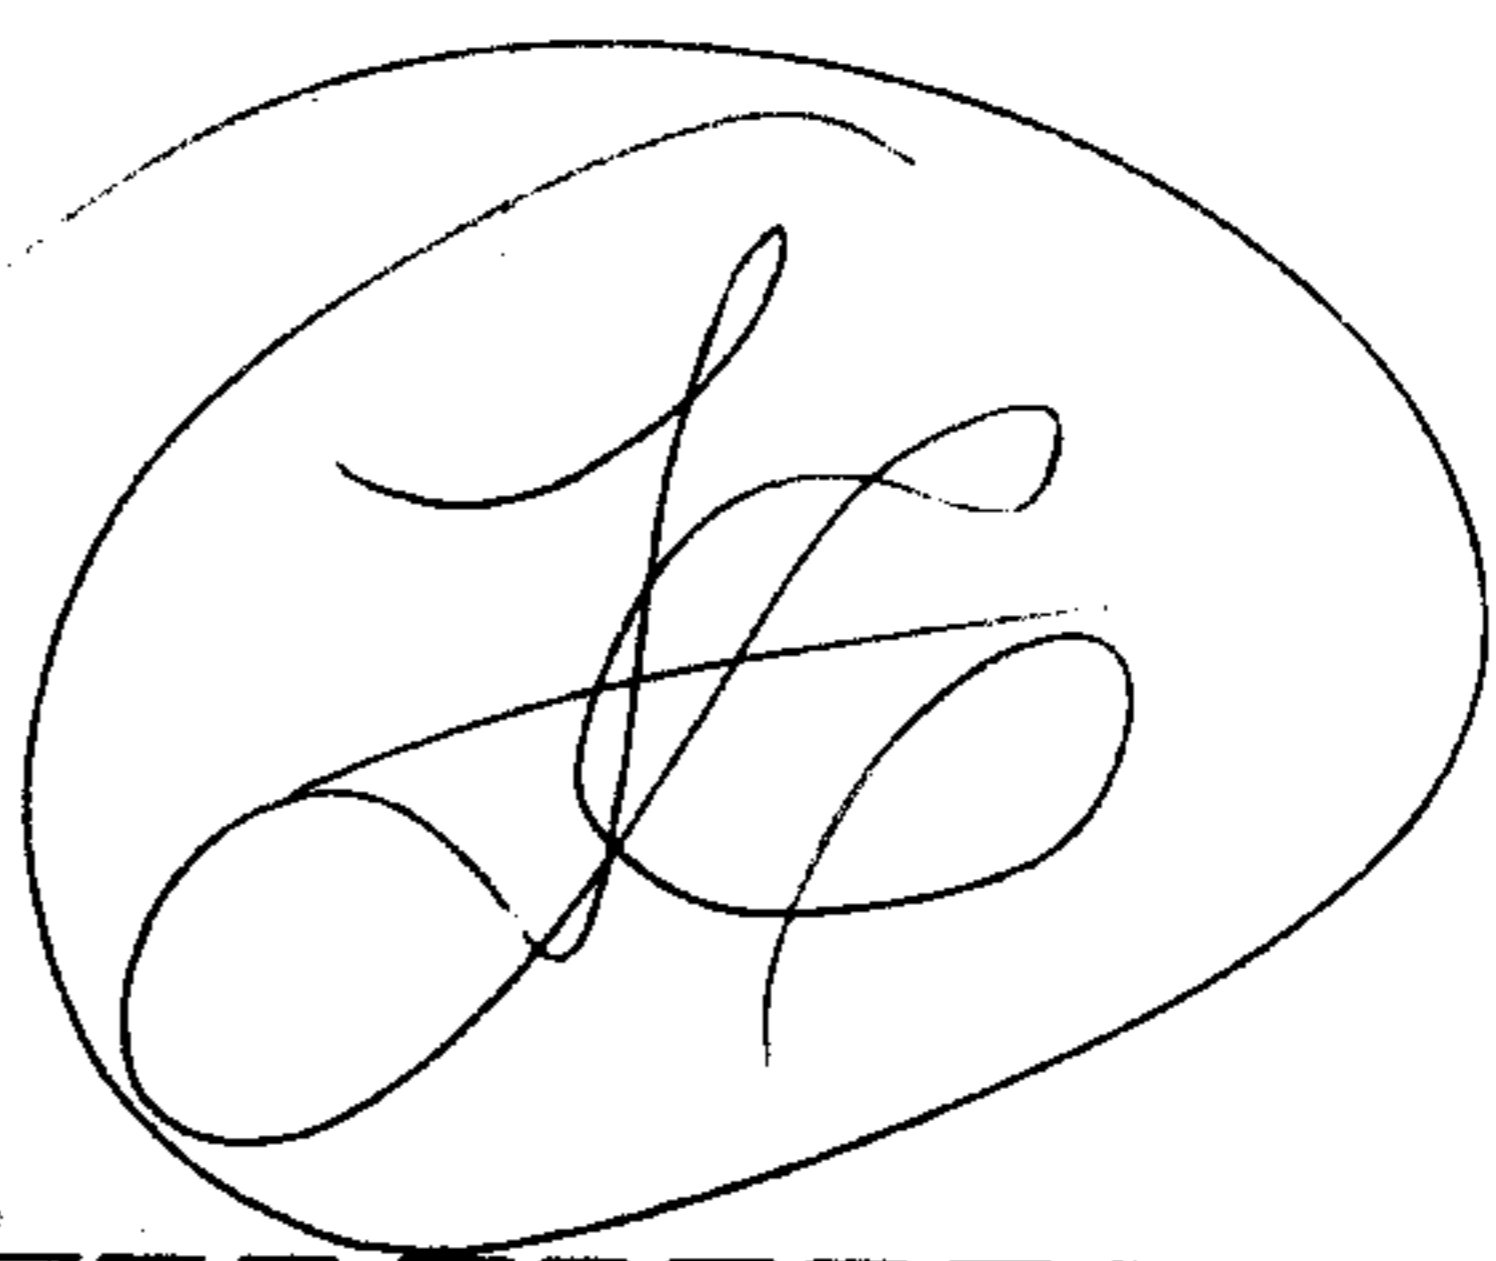


#2317
 APPROVED
 LORAIN CO.
 MAP DEPT.
 DATE 12-11-68
 21-G
 BY L W HADON

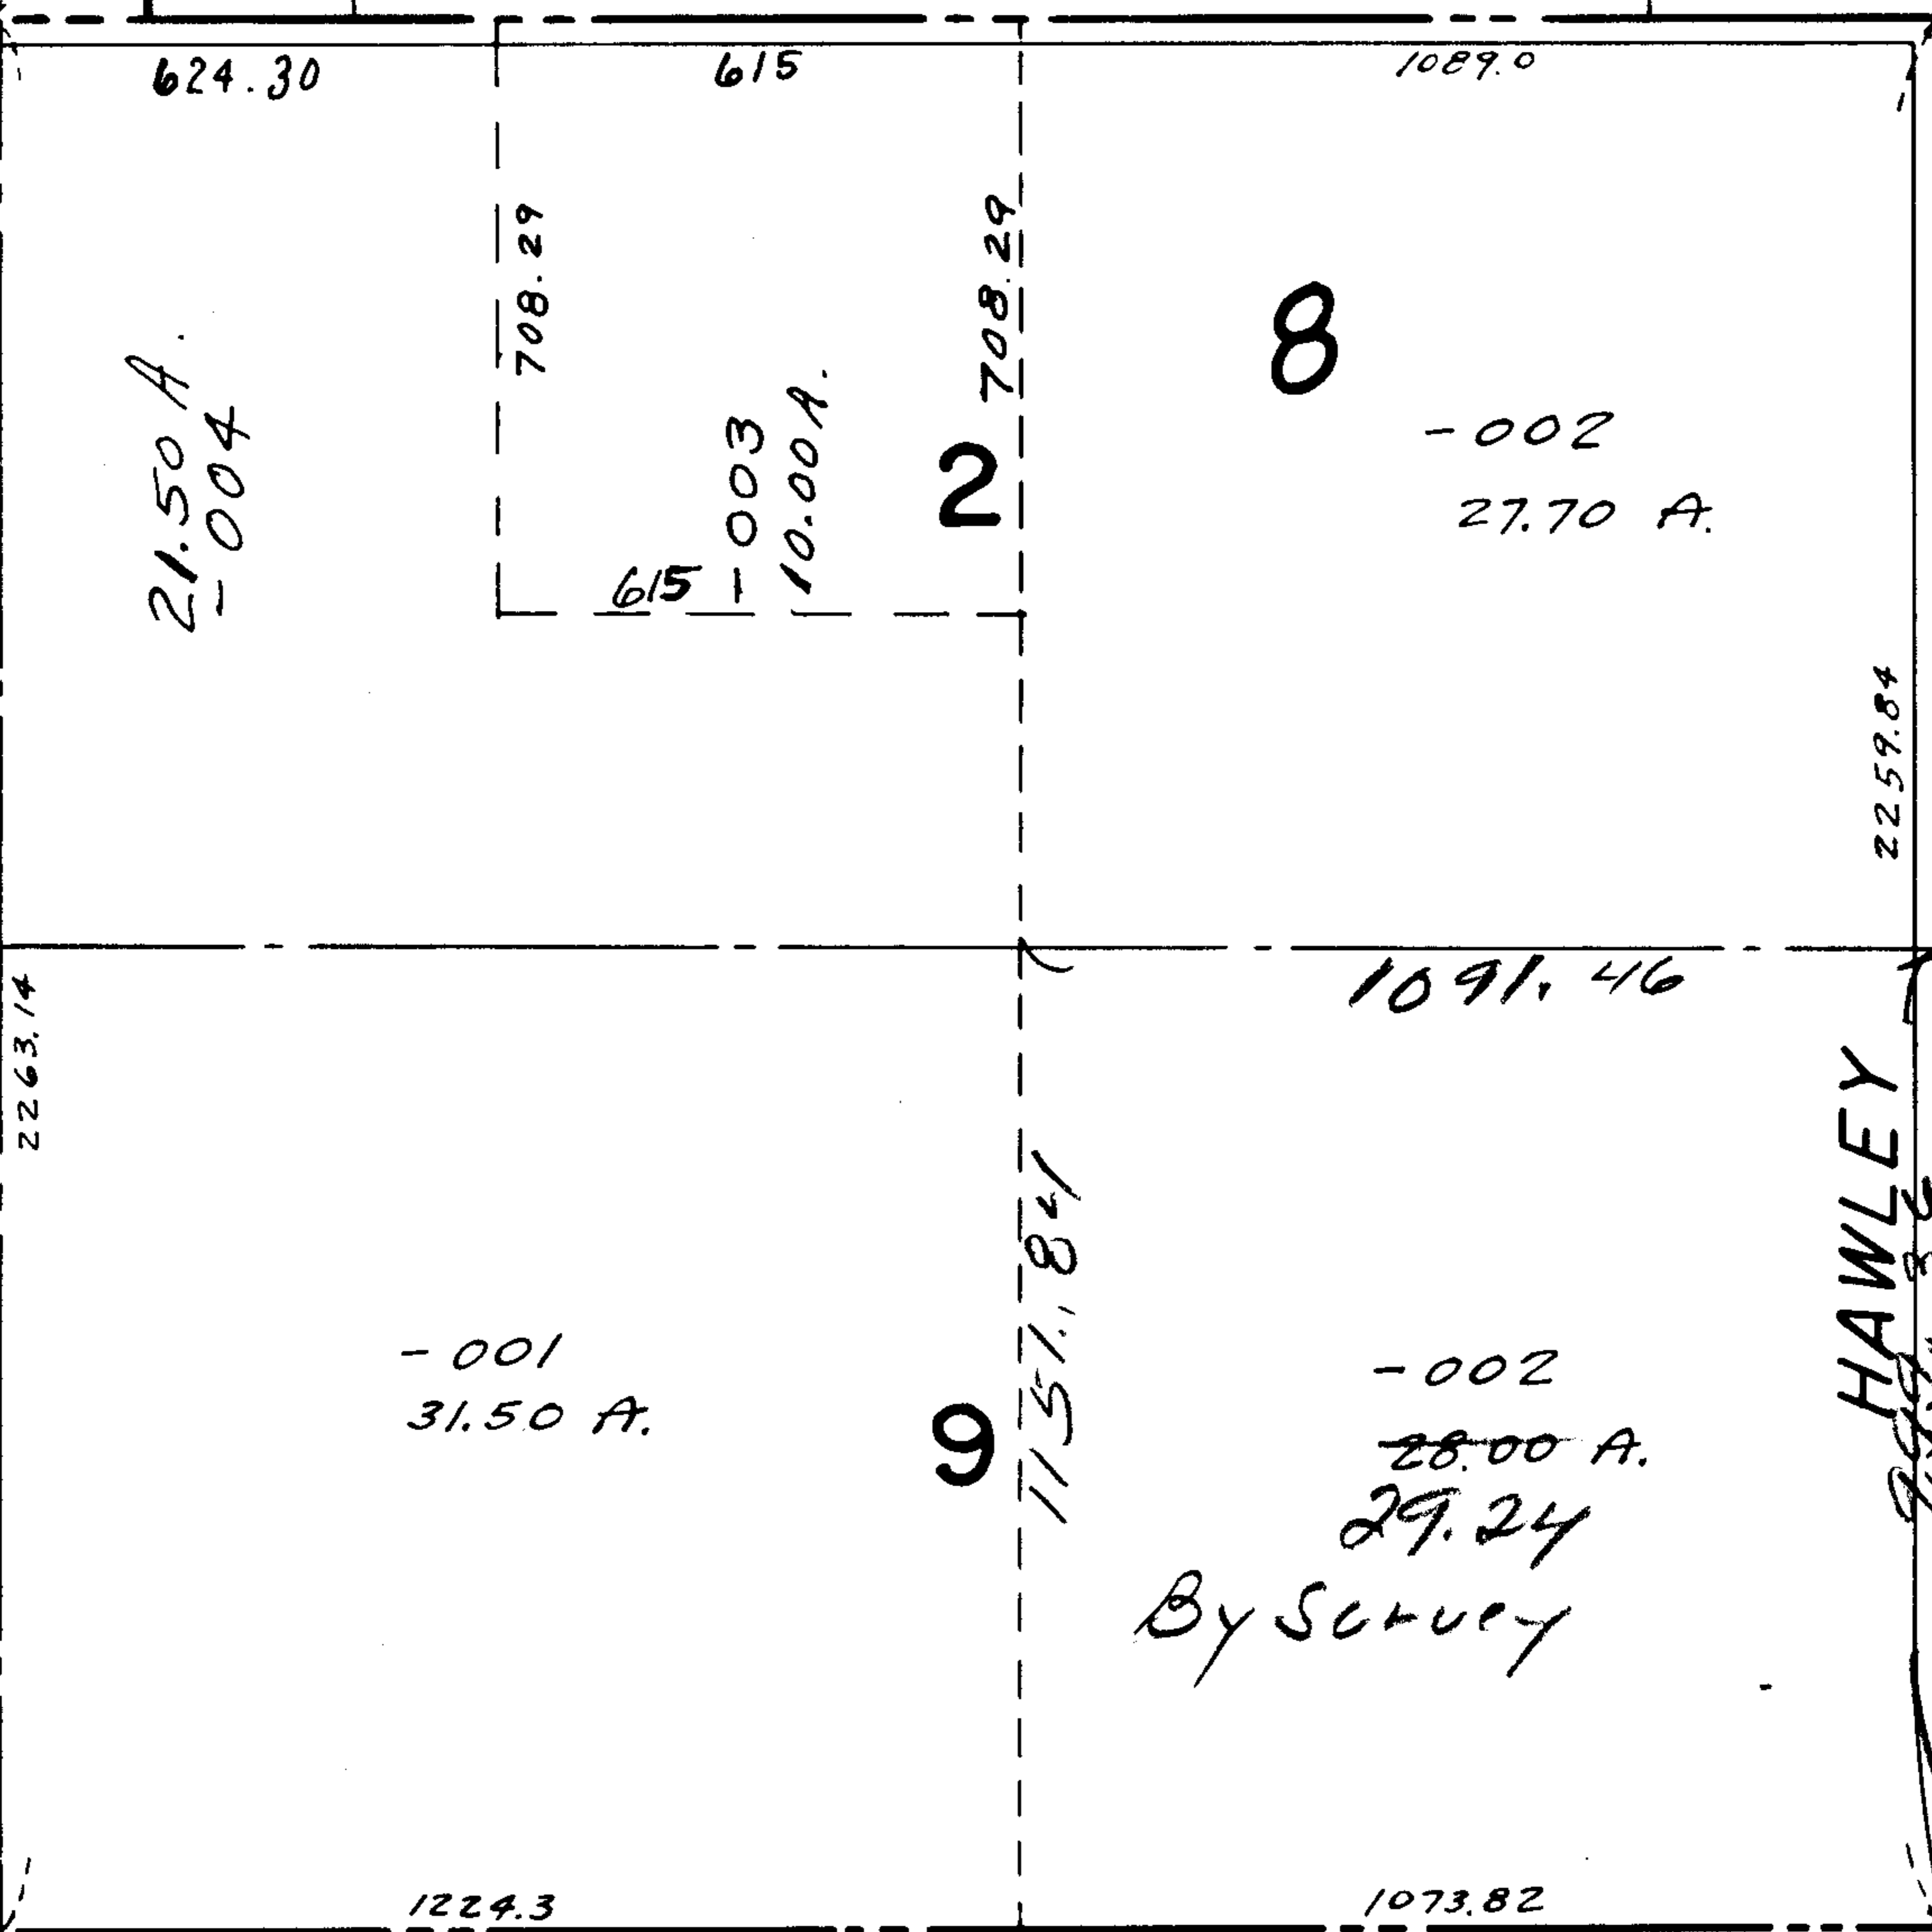

JAN 22 1969

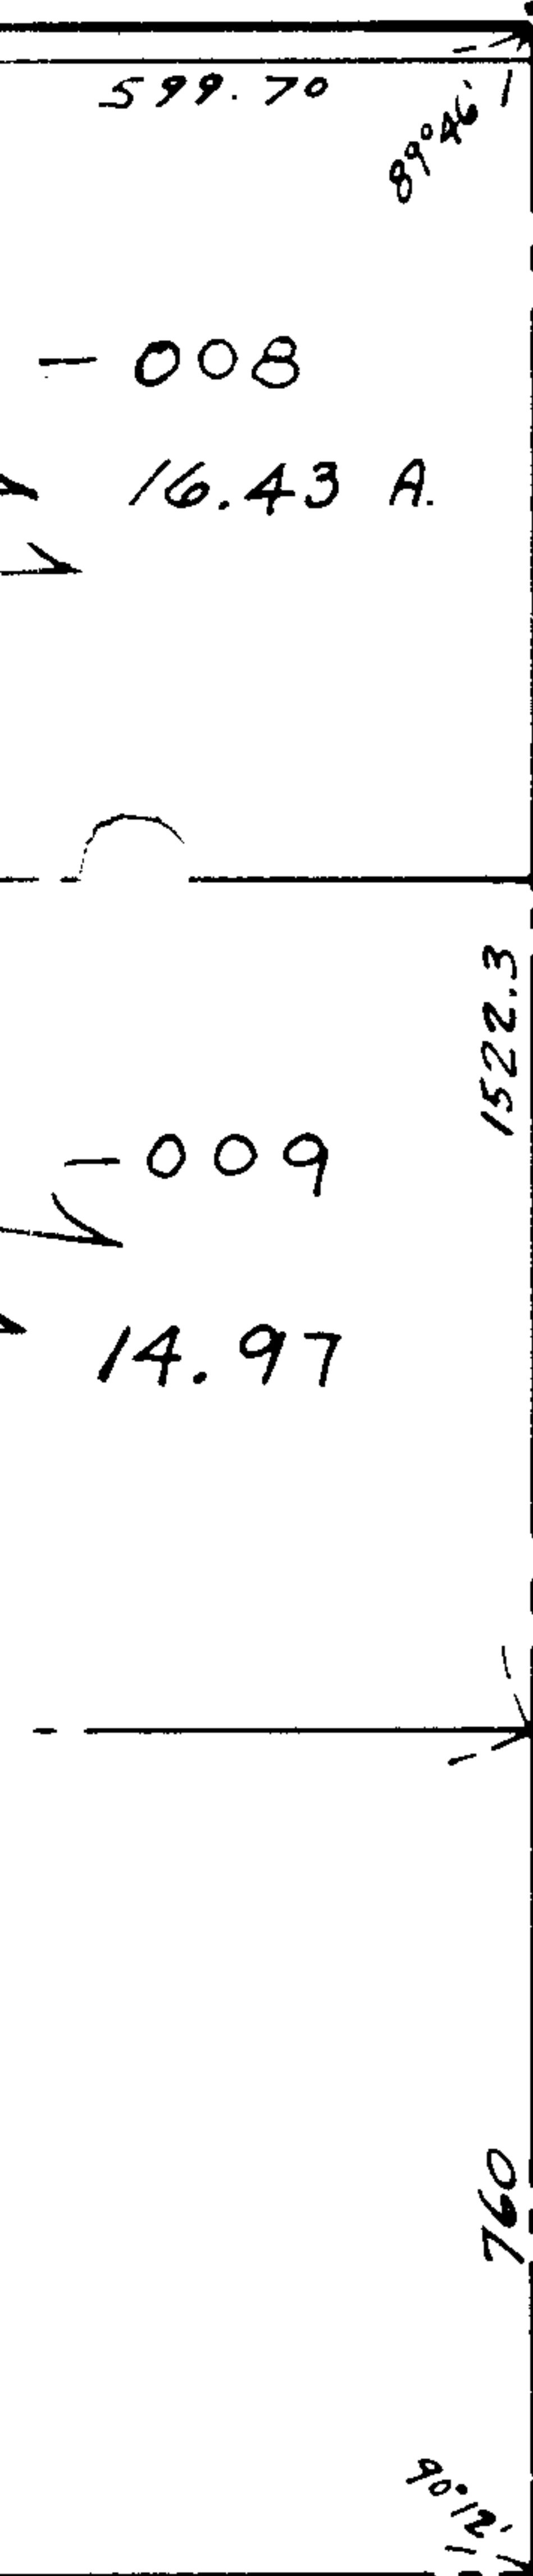

WP.
 21-G

TRACT 8 LOTS 1, 2,
 TRACTS 9, 10, 11, 13, 14,
 TRACT 17 LOT 15