

60

-002
12.00 A.

60

-001
4.50 A.

RD.

131.56

-008
-003
~~53.78 A.~~
38.86 A

-007
17.72 A.

627.66

88.50

74.70

107.45

2680

3

-004
40.00 A.

1125

1125


-005
28.00 A.

2680

-006
25.00 A.

2328

-001
40.00 A

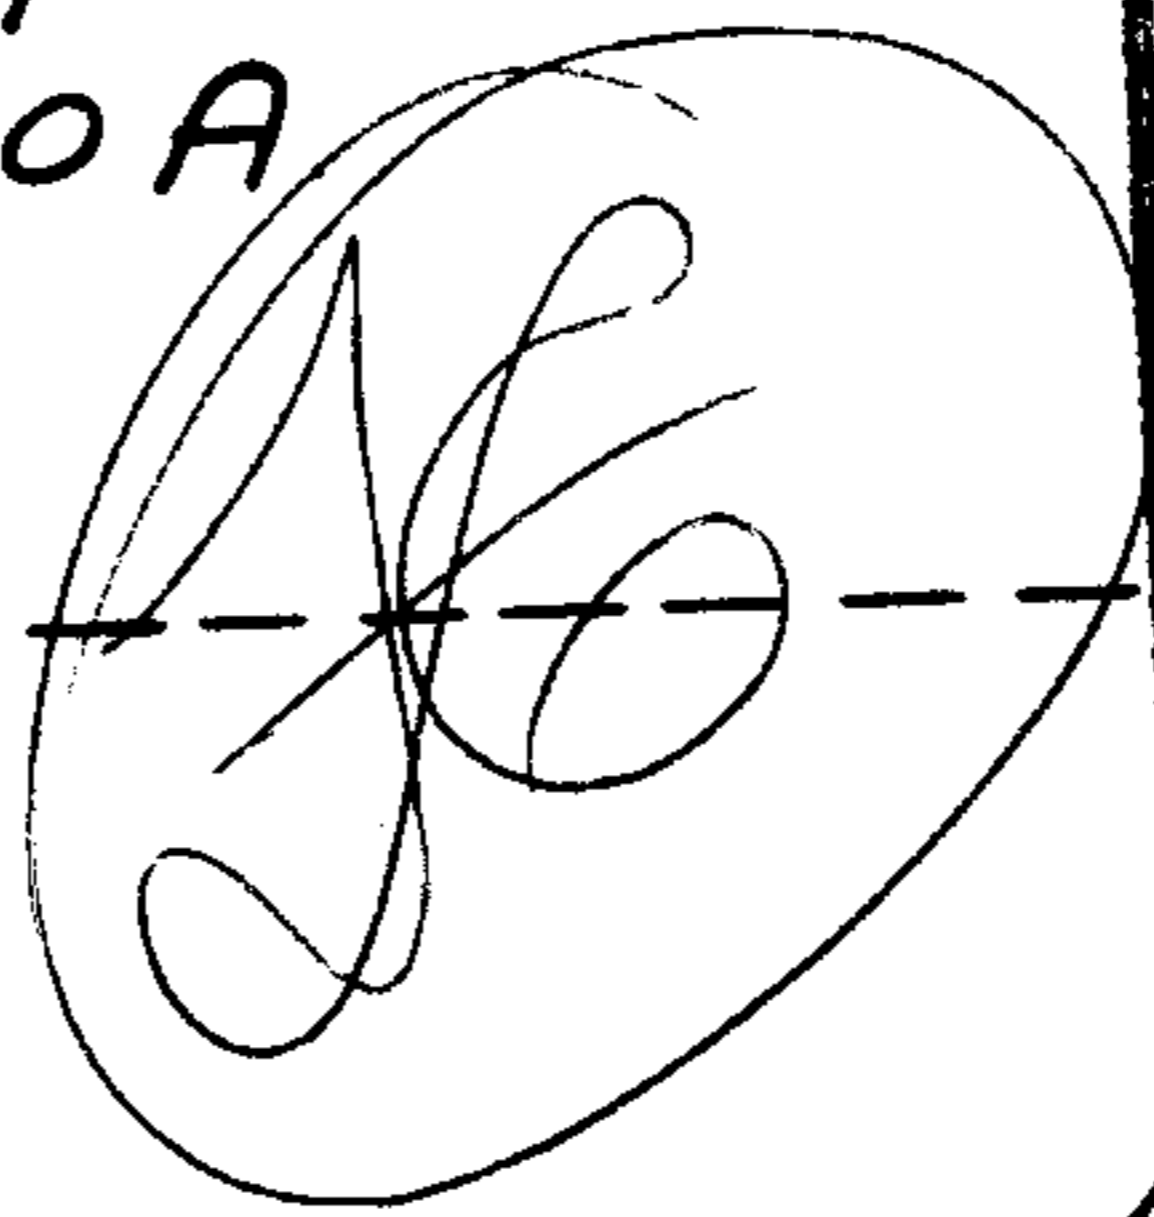

APPROVED
LORAIN CO.
MAP DEPT.
DATE 12/13/68
Dy 15-A
BY R.J. Kelling

7-798-584

-002
42.00 A.

JAN 22 1969

18

720

-003

