


1092.30

1848

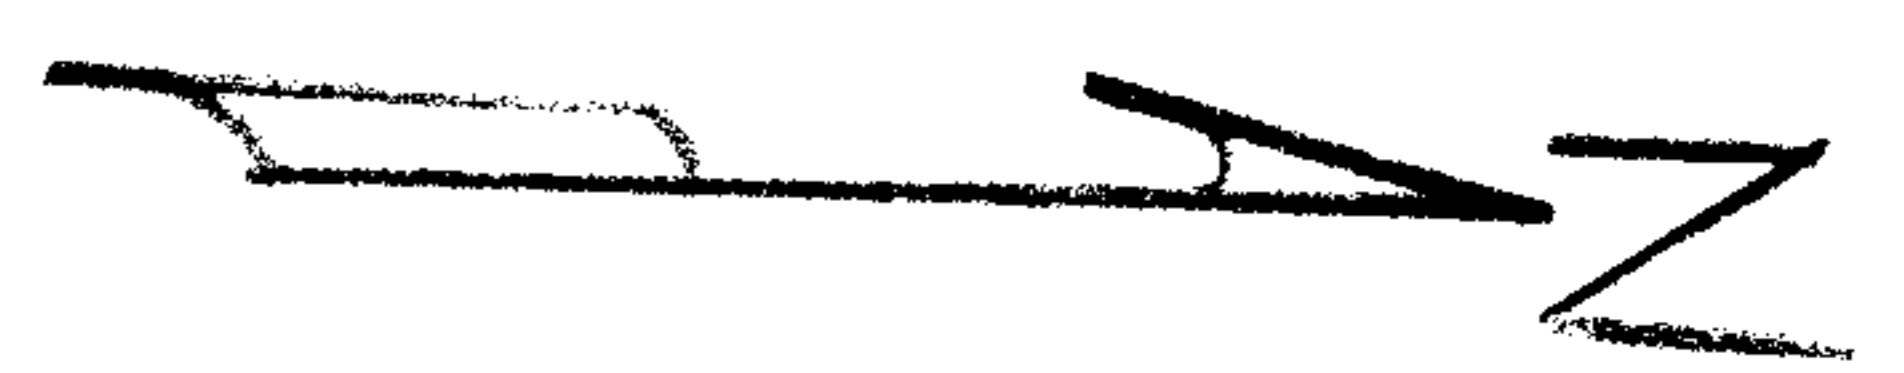

-014
38.00 A.

-013
20.00 A.

-007
55.11 A.

1056

825

1857.90

1872.89

-015
20.00 A

-010
56.23 A.

330
-018
0.76 A.
-019
0.76 A.
330
-020
0.76 A.
-021
0.76 A.

~~045~~
~~045~~
~~046~~
29.69 A.
~~26.31~~
24.31

691.12

1562.50
871.38

691.12

330
-022
1.52 A.
330
800
-023
3.67 A.
800

1089

1537.26

24

800
-039
2.69 A.
1147.63
1887.60
17.59

-031
20.45 A.

150
-040
3.83 A.
1176.50


150
-038
3.48 A.
1110.20
222.12

250
-033
4.04 A.
616.33

200
-027
2.49 A.
487.19

8.8.7-29

2343
MAR 5 1969

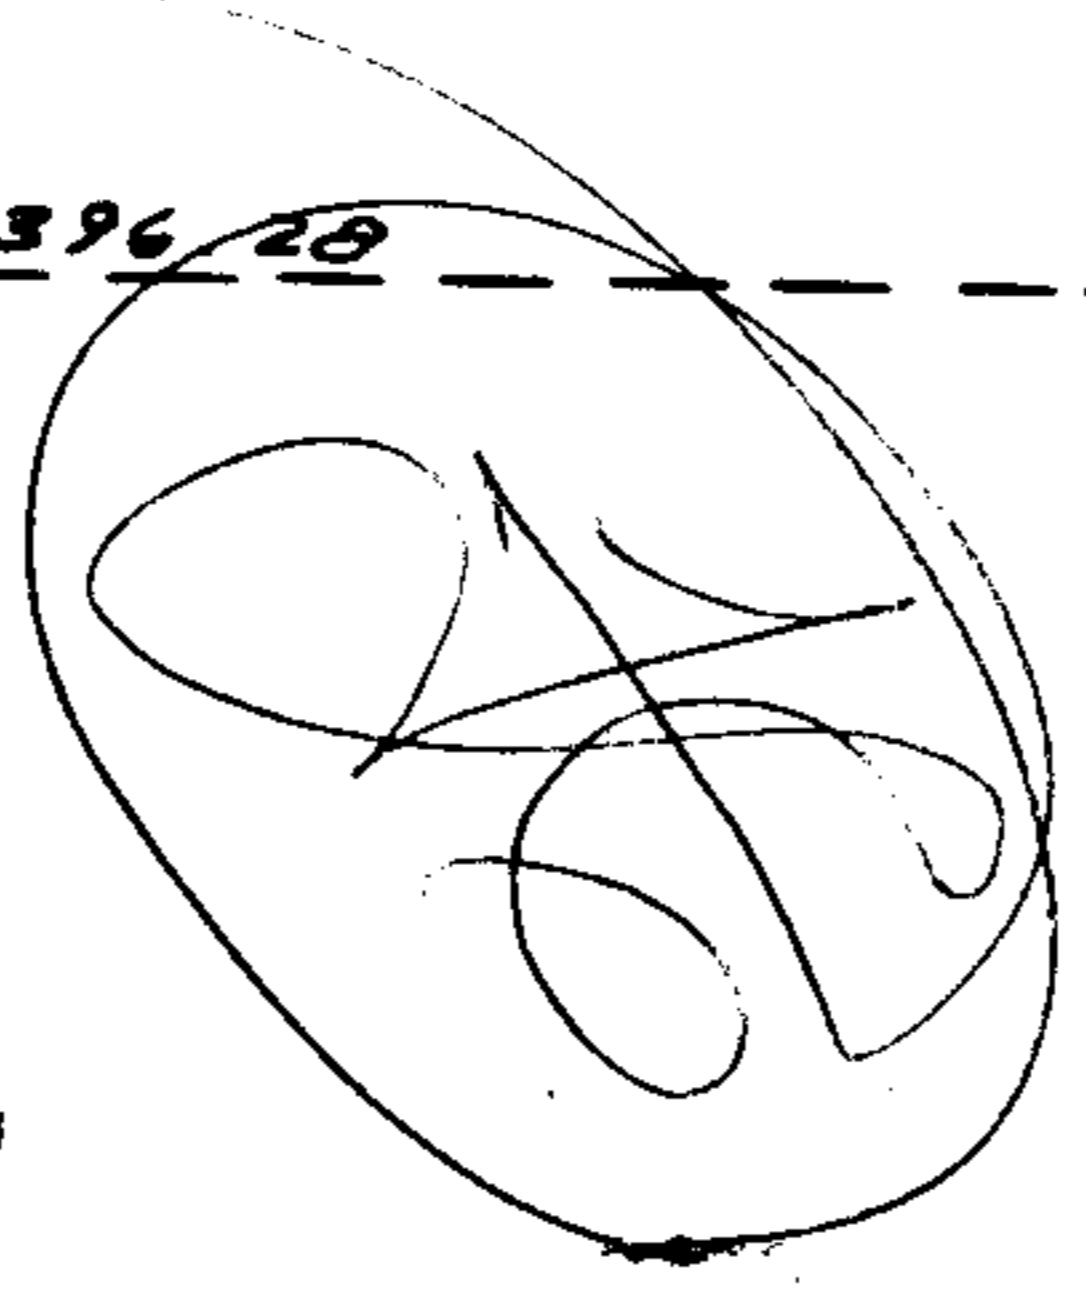

-012
114.00 A.

-025
63.00 A

APPROVED
LORAIN CO.
MAP DEPT.
DATE 12/19/68
BY [Signature]