

-0.13
1.63A.

794.73

-0.09
1.78A.

796.30

507.69

-0.18
1.30A

287.56

184.10

331.06

-0.12
~~-0.12~~
10.23A.
7.99A.

N. 6° 28' 30" E.
204.66

v.e.r

76.22

N. 190° 55' E.
407.0320148

96.38

175.17
14.64
197.41

ROBSSON RD

600.15

100

160.90
190.44

78.81

22.55

276.45


-0.07
1.27A.

227.20

222.32

878.86

MAR 5 1969

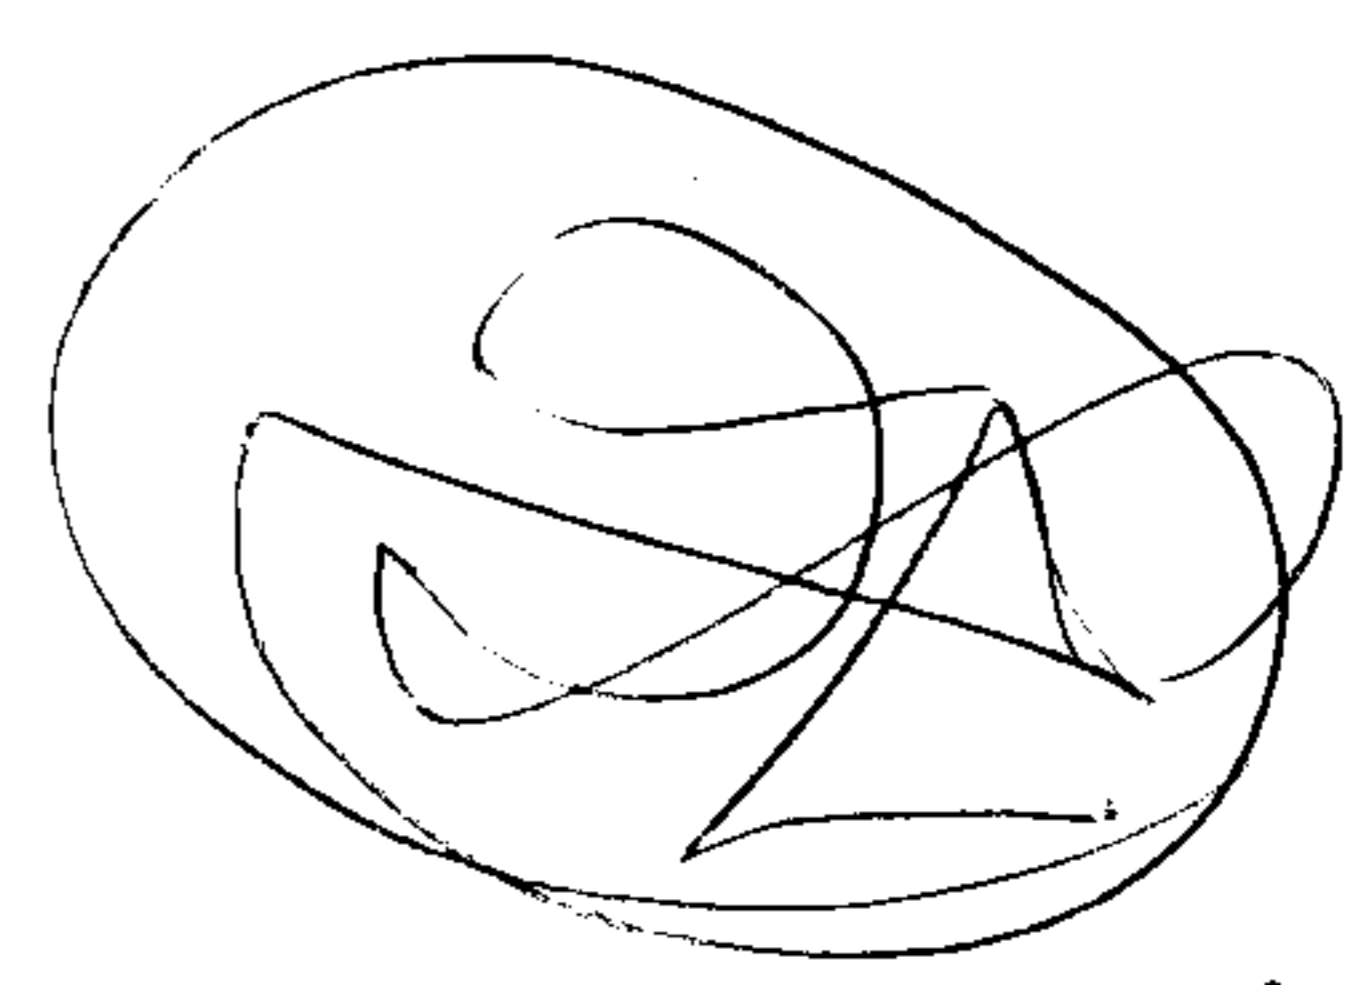

2365

R/7-31-86

MAR 5 1969

APPROVED
LORAIN CO.
MAP DEPT.
DATE 1/2/59
B/10-00-015-F
BY R. J. Kelling