

89

- 008
35A.

80

80

45

190

- 009
22A.



50

50


190

R.D.

804 54

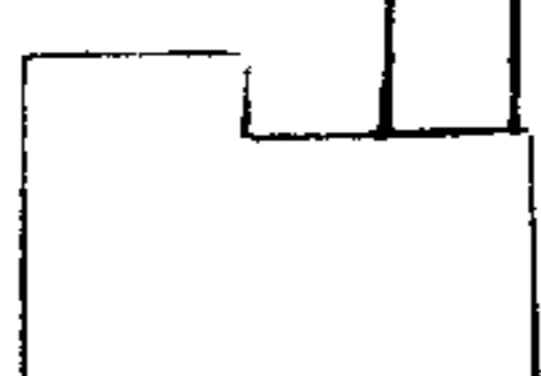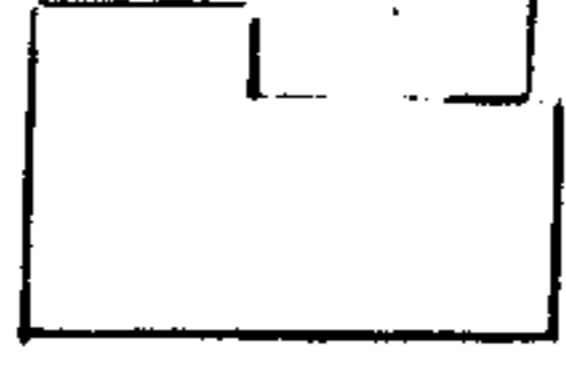

1" = 100 FT

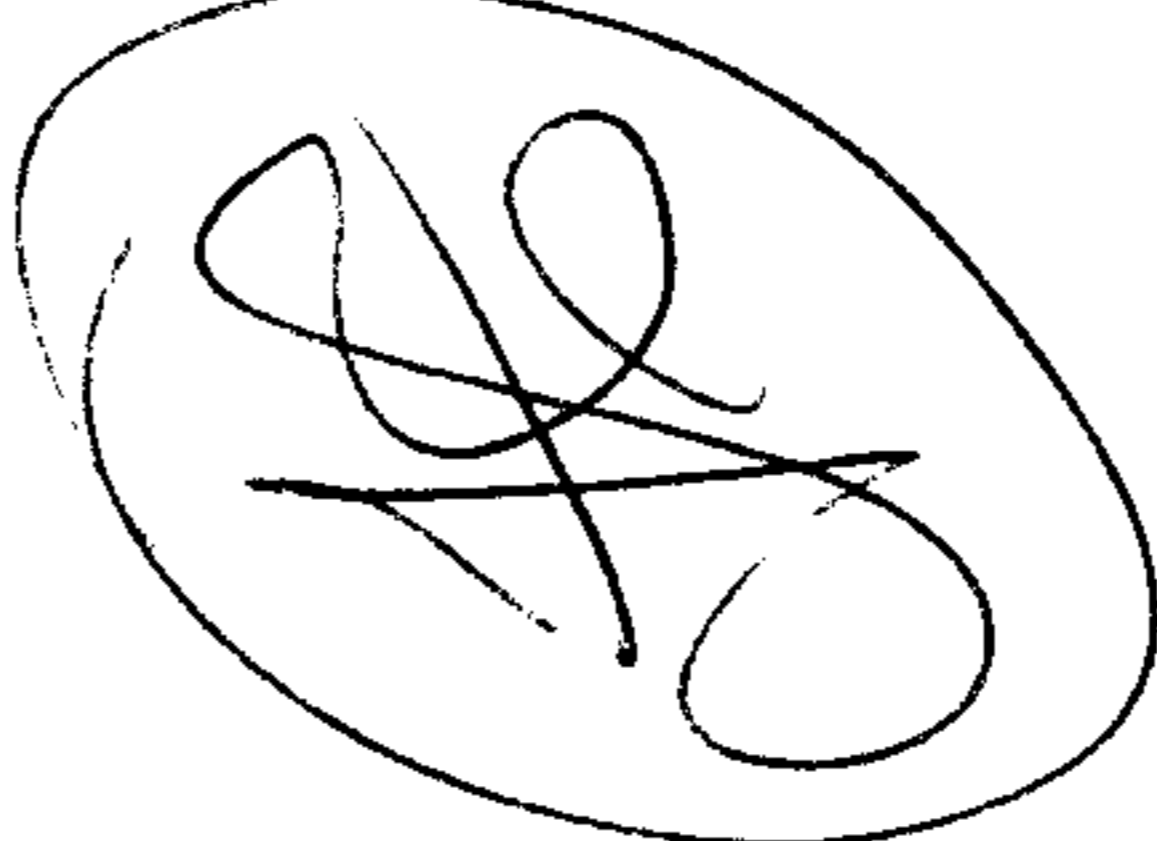

Pt. - 018 - 019
Pt. ~~37.45A.~~ 31.01A.

23 69

JAN 23 1969

D. S.
7-25-68

APPROVED
LORAIN CO.
MAP DEPT.
DATE 1-4-69
10-00-005-6
BY <i>Hollbrook</i>

125

- 010
55A.

P

190