

SEE 6-143

1011.78

Pt. -008

Pt. 50.87 A.

9009

45

RD.

30

100

100

250

500

150

190

-011
.44 A.

-012
.44 A.

190

190

-001
.44 A.


190

-019
.44 A.


190

Pt. 10-00-005-101-~~018~~
Pt. 31.45 A.

-019
31.01 A.

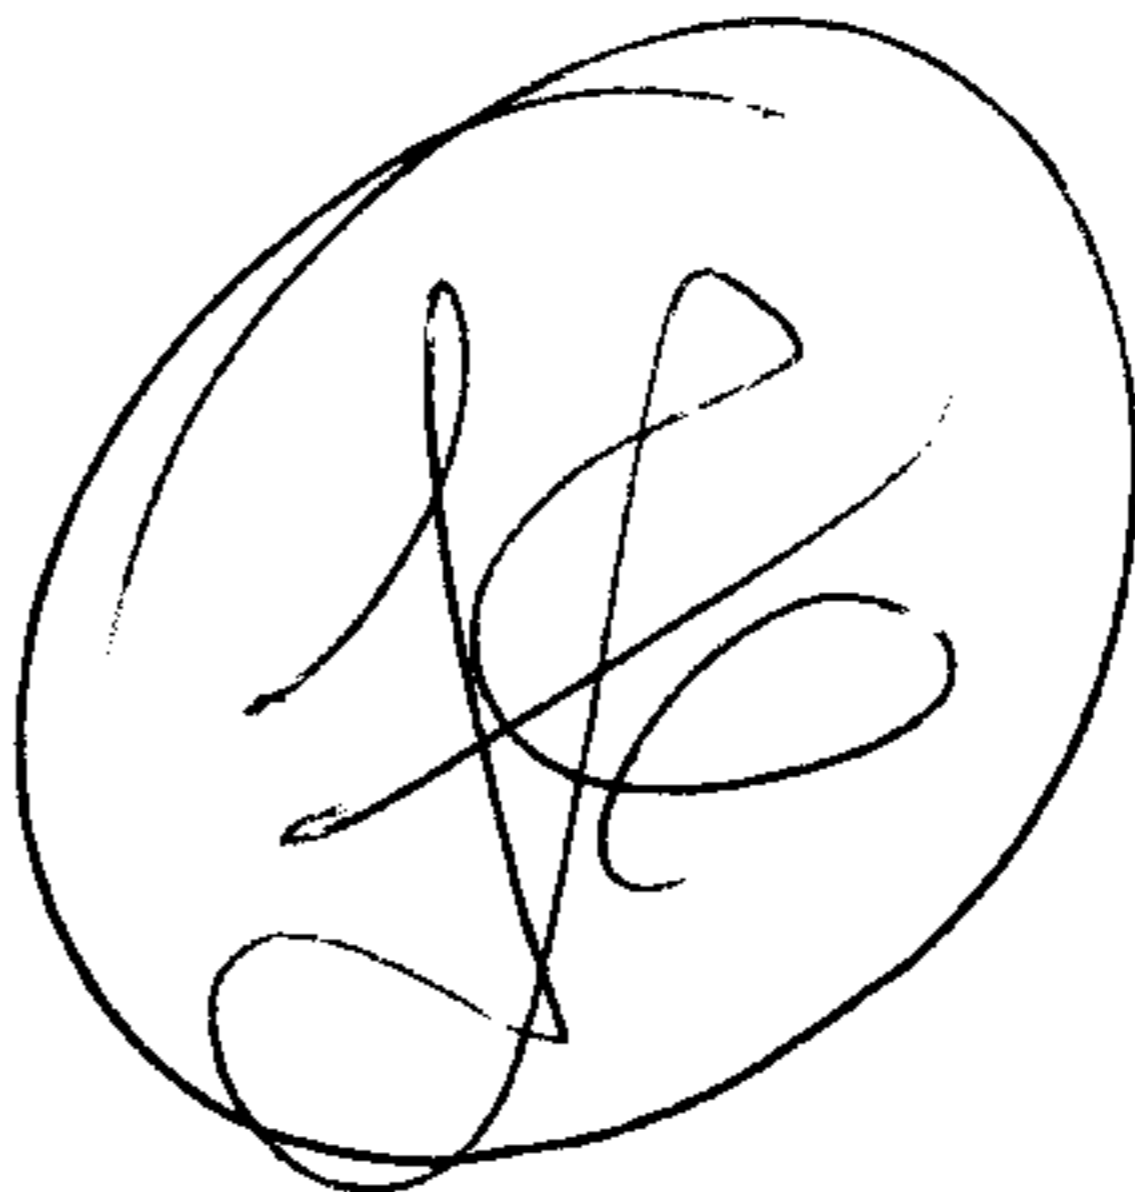

S.S. 7-25-88

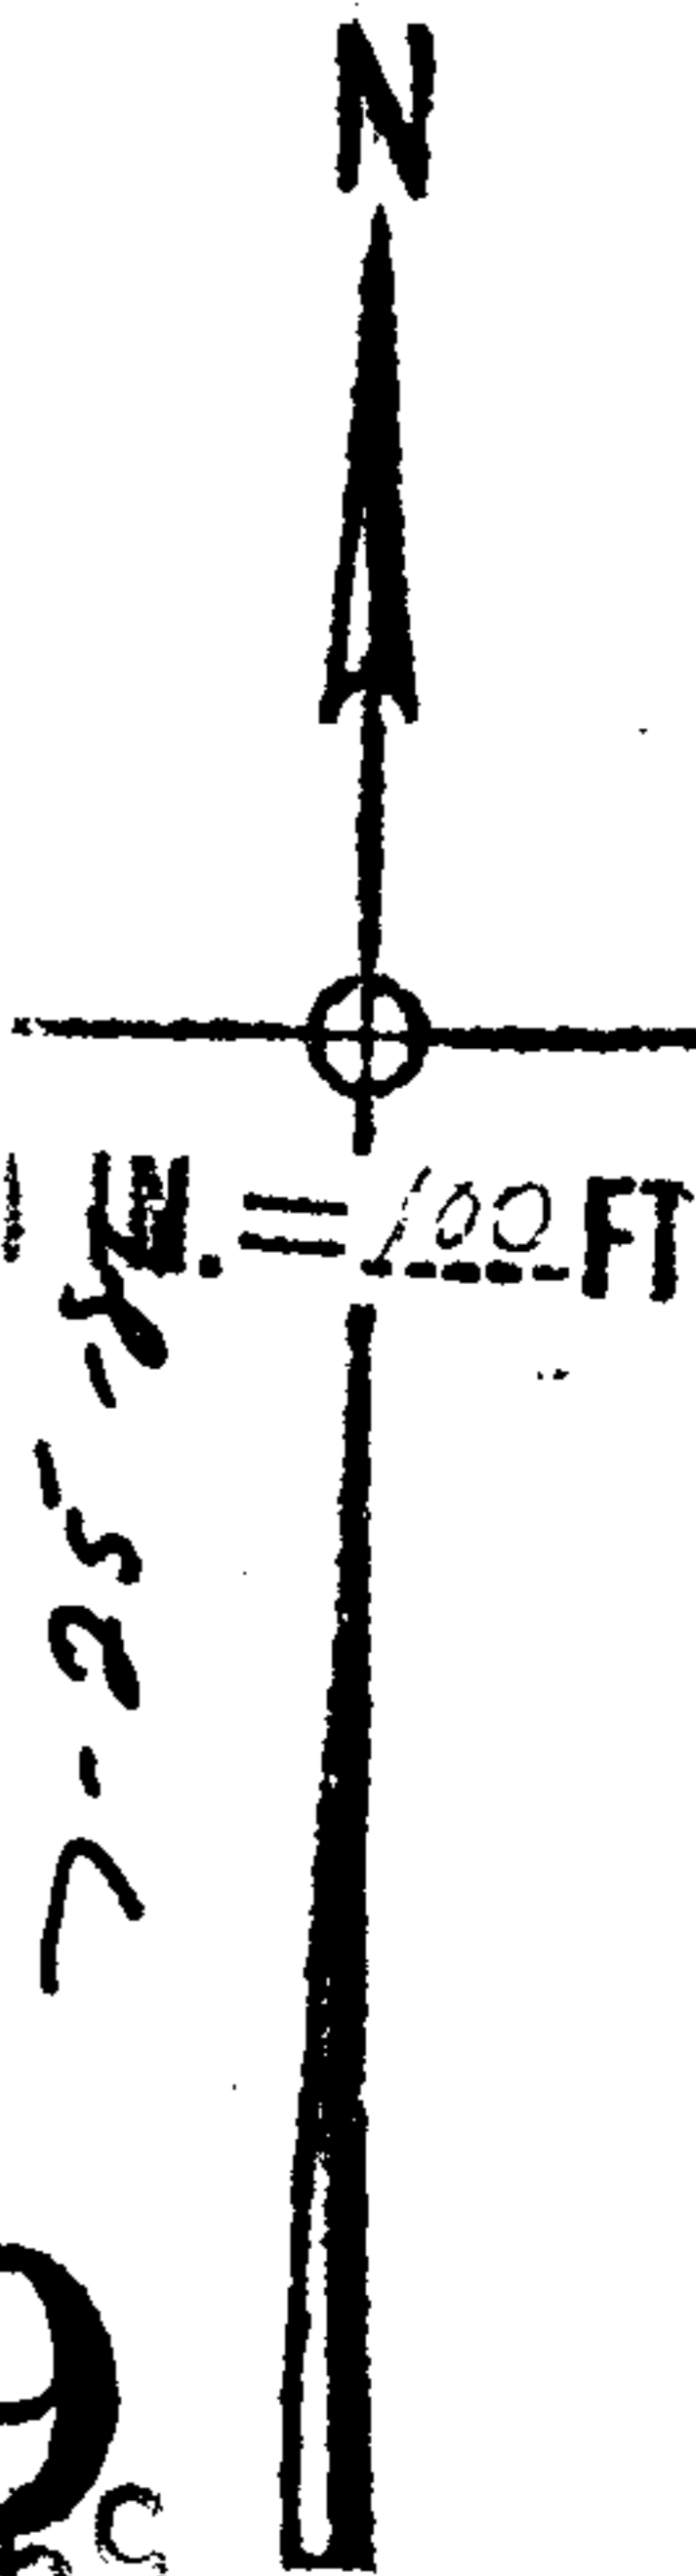

2369
JAN 9 1969

APPROVED
LORAIN CO.
MAP DEPT.

DATE 1-4-69

10-00-005-C

BY

Hollerik

102

678.50

-002
2.33 A.

31.45
44
31.01

150

1262.9