

MAR 5 1969

STOCKING

RD.

APPROVED
LORAIN CO.
MAP DEPT.

DATE 1/21/69

Pg 20-B

BY
R.L. Kelling

S.S.
2-29-69



2399

MAR 26 1969

-001
10.00 A.

-002
38.00 A.

GRIGGS

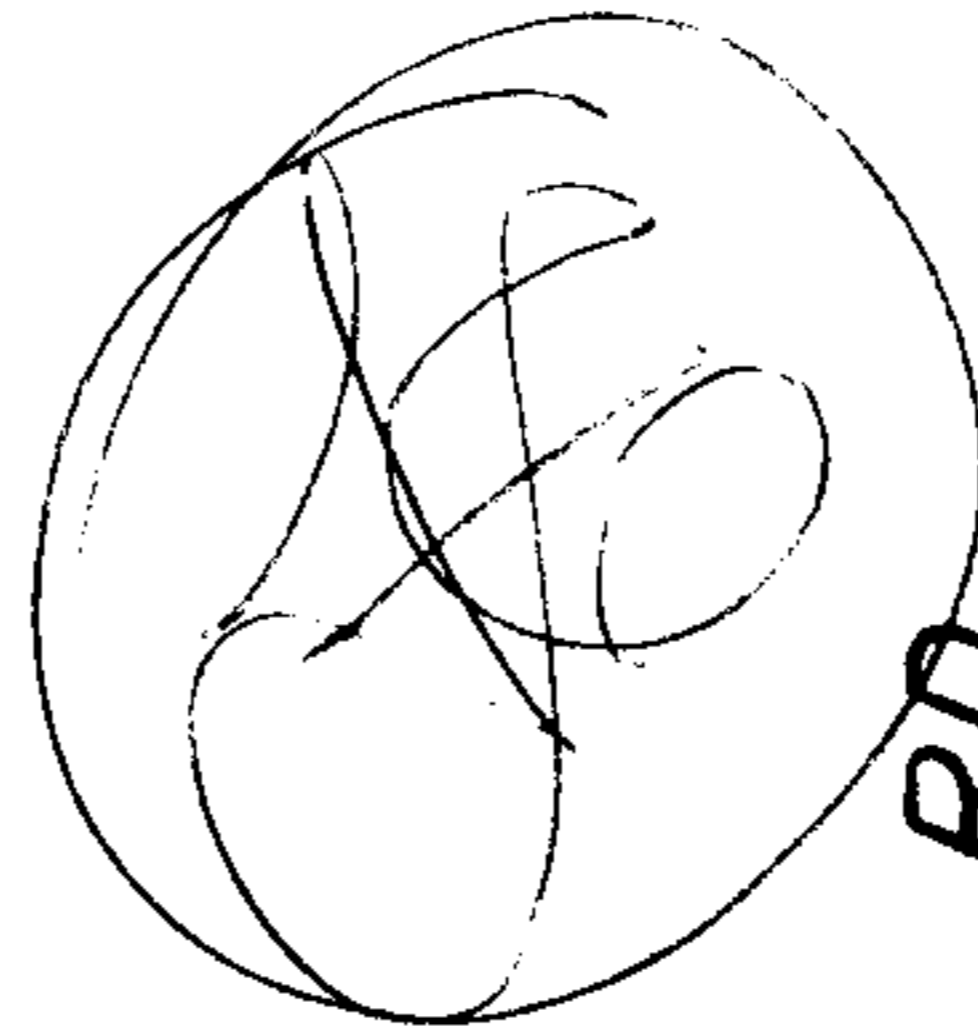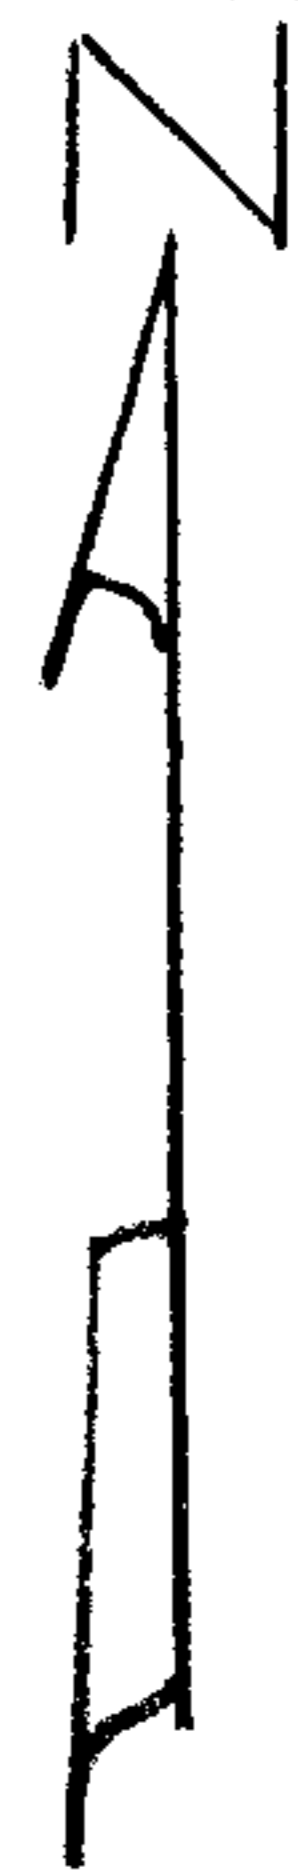

-005
~~-001~~
~~76.00 A.~~
65.93

P
-004
10.07 A

14
-002
46.00 A.

-003
63.19 Map
63.00 Dup.

S
T
R
I
P

GORE - 1254 ORPHANGE RD

1254

507.85
186.52
574.24
638

2199.12

(?)

(?)

RD.

(60)

(60)