

04
43.48A.

-006
10.07A.
865.92
489.72

3.60
300
376.80
-004.88A
336.80

-005
50.19A.

466.62

8°30'
497.5
590.6

104°54'
416.30
75°06'

T

-001
1.85A.
336.80

-002
9.775A.

577.74
-004
3.80A.
943.50

C


181.5
-005
120
181.5

A

-003
34.17A.

R 20

-004
54.25A.

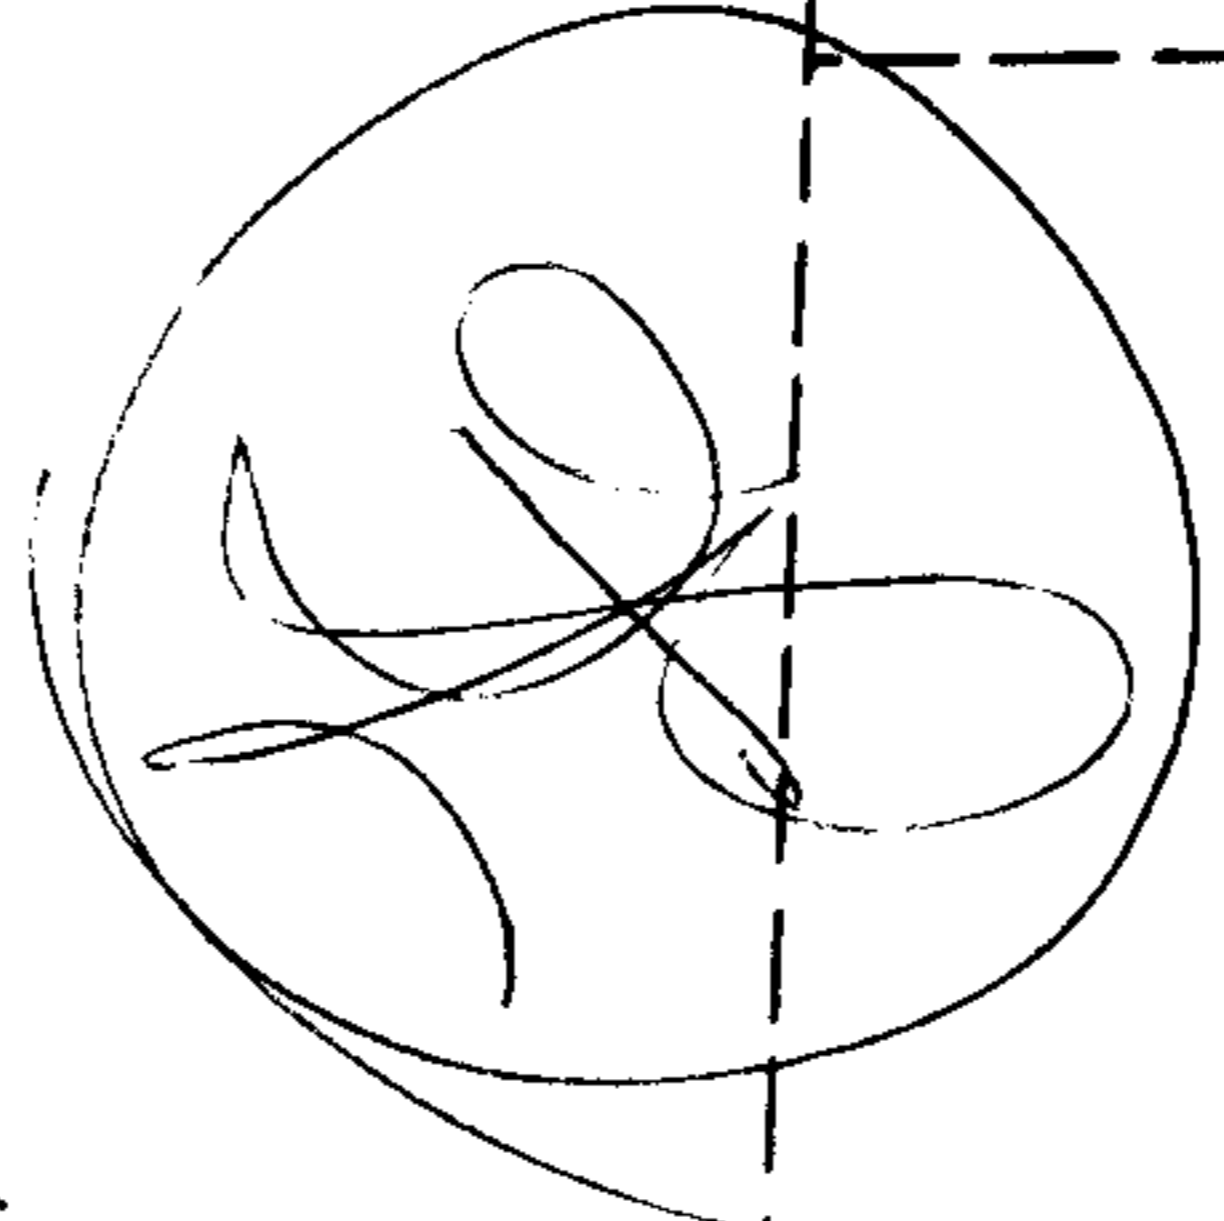

2405
~~2020~~

WARD

03
18A.

1570
1488.40

-008
-004
40.43A
37.57A

MAR 5 1989

5.89

1634.16

150
-005
1.00A.
290
150
290
150

RD.

533.28

-001
5.00A.
533.28

-002
15.00A.

1734.48

1309.

APPROVED
M LORAIN CO.
MAP DEPT.
DATE 1/27/69
BY B. B. E.
Reukelling