

- 009
22.00A.

- 001
22.00A.

- 002
51.46A.

73

- 003
24.00A.

- 004
11.00A. Dup.
18.00A. Pl.
10.50A. D.

- 015
8.65

- 008
17.73A.

- 009
19.00A.

AKINS

RD.


MAR 5 1969

APPROVED
LORAIN CO.
MAP DEPT.

DATE 1/23/69

PG 12-E

BY R.V. Kelling

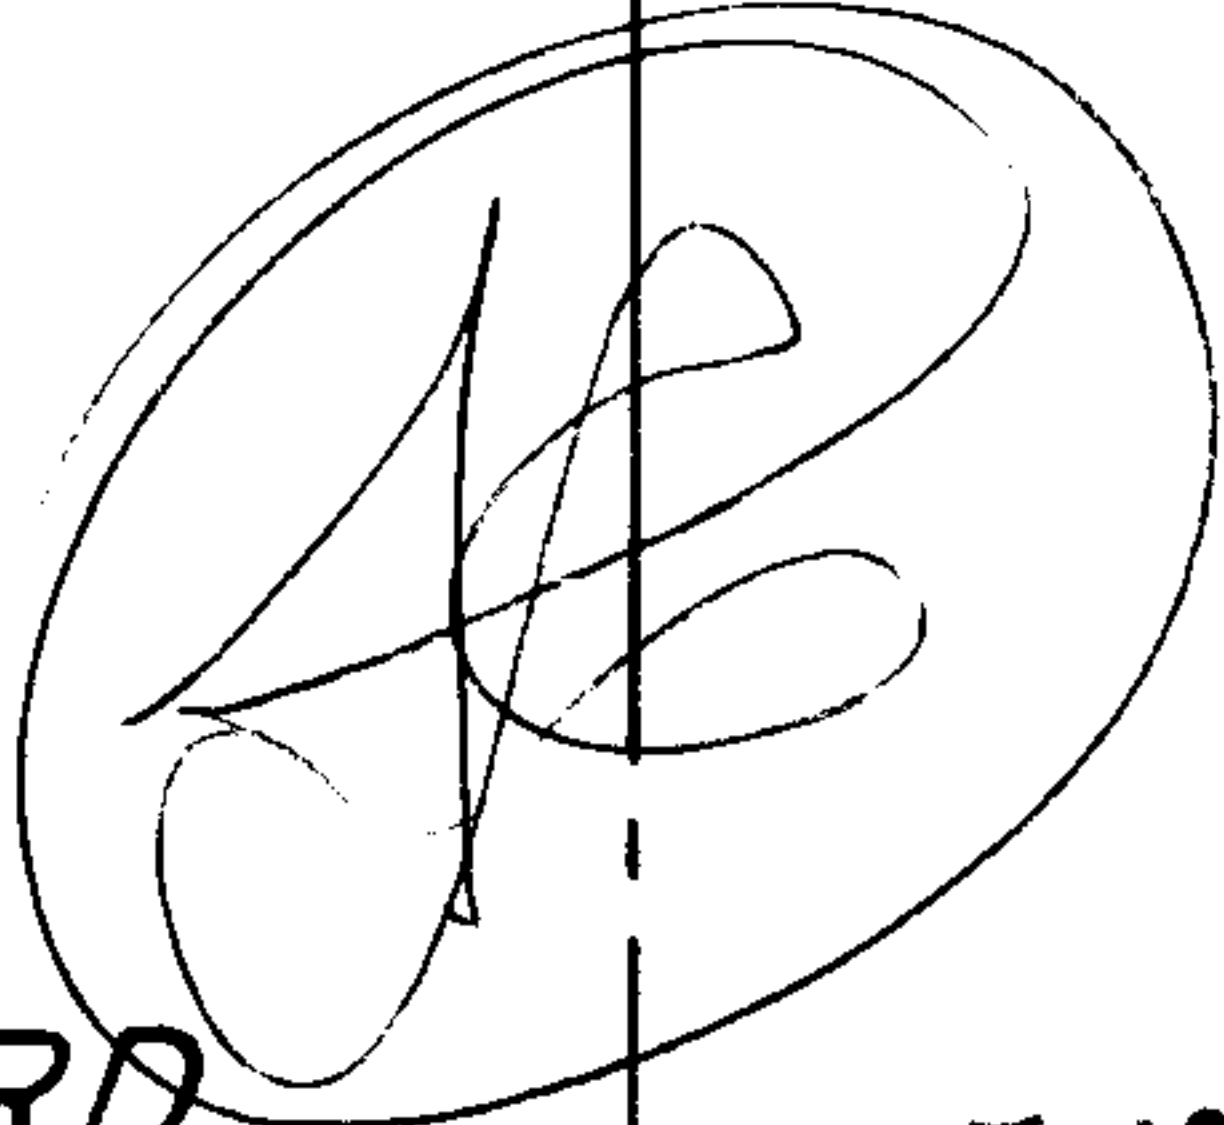

S.S.
1-30-69

- 013
9.84A

278.97
1376

- 012
5.16A

10 00 A

- 015
14.38A.

222 217.8 141.42 90.78
- 001 - 002
21.02A 1.00A
225 217.8 111.56
331.41
- 010 - 014
3.00A 2.91A
309.90 589.90
398.22 253.01

JAN 23 1969

2406