

87.92 58.63 87.98 58.67 117.38 148.80 88.12 58.77 176.38 117.65 58.8

SHEFFIELD - FRENCH GREEN 400'

160

Pt - 022

Pt 18.90

~~Pt - 020~~



~~Pt. 24.93~~

- 021
5.43 A

- 017
2.17 A.

400'

160

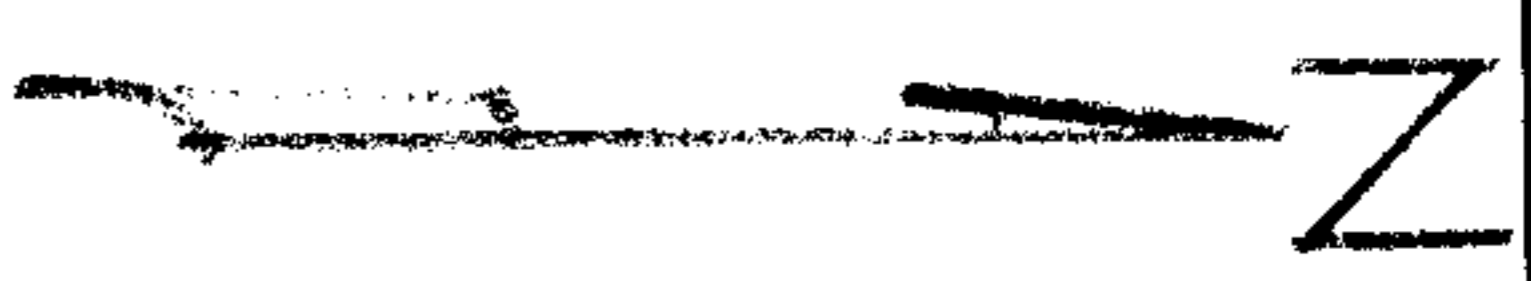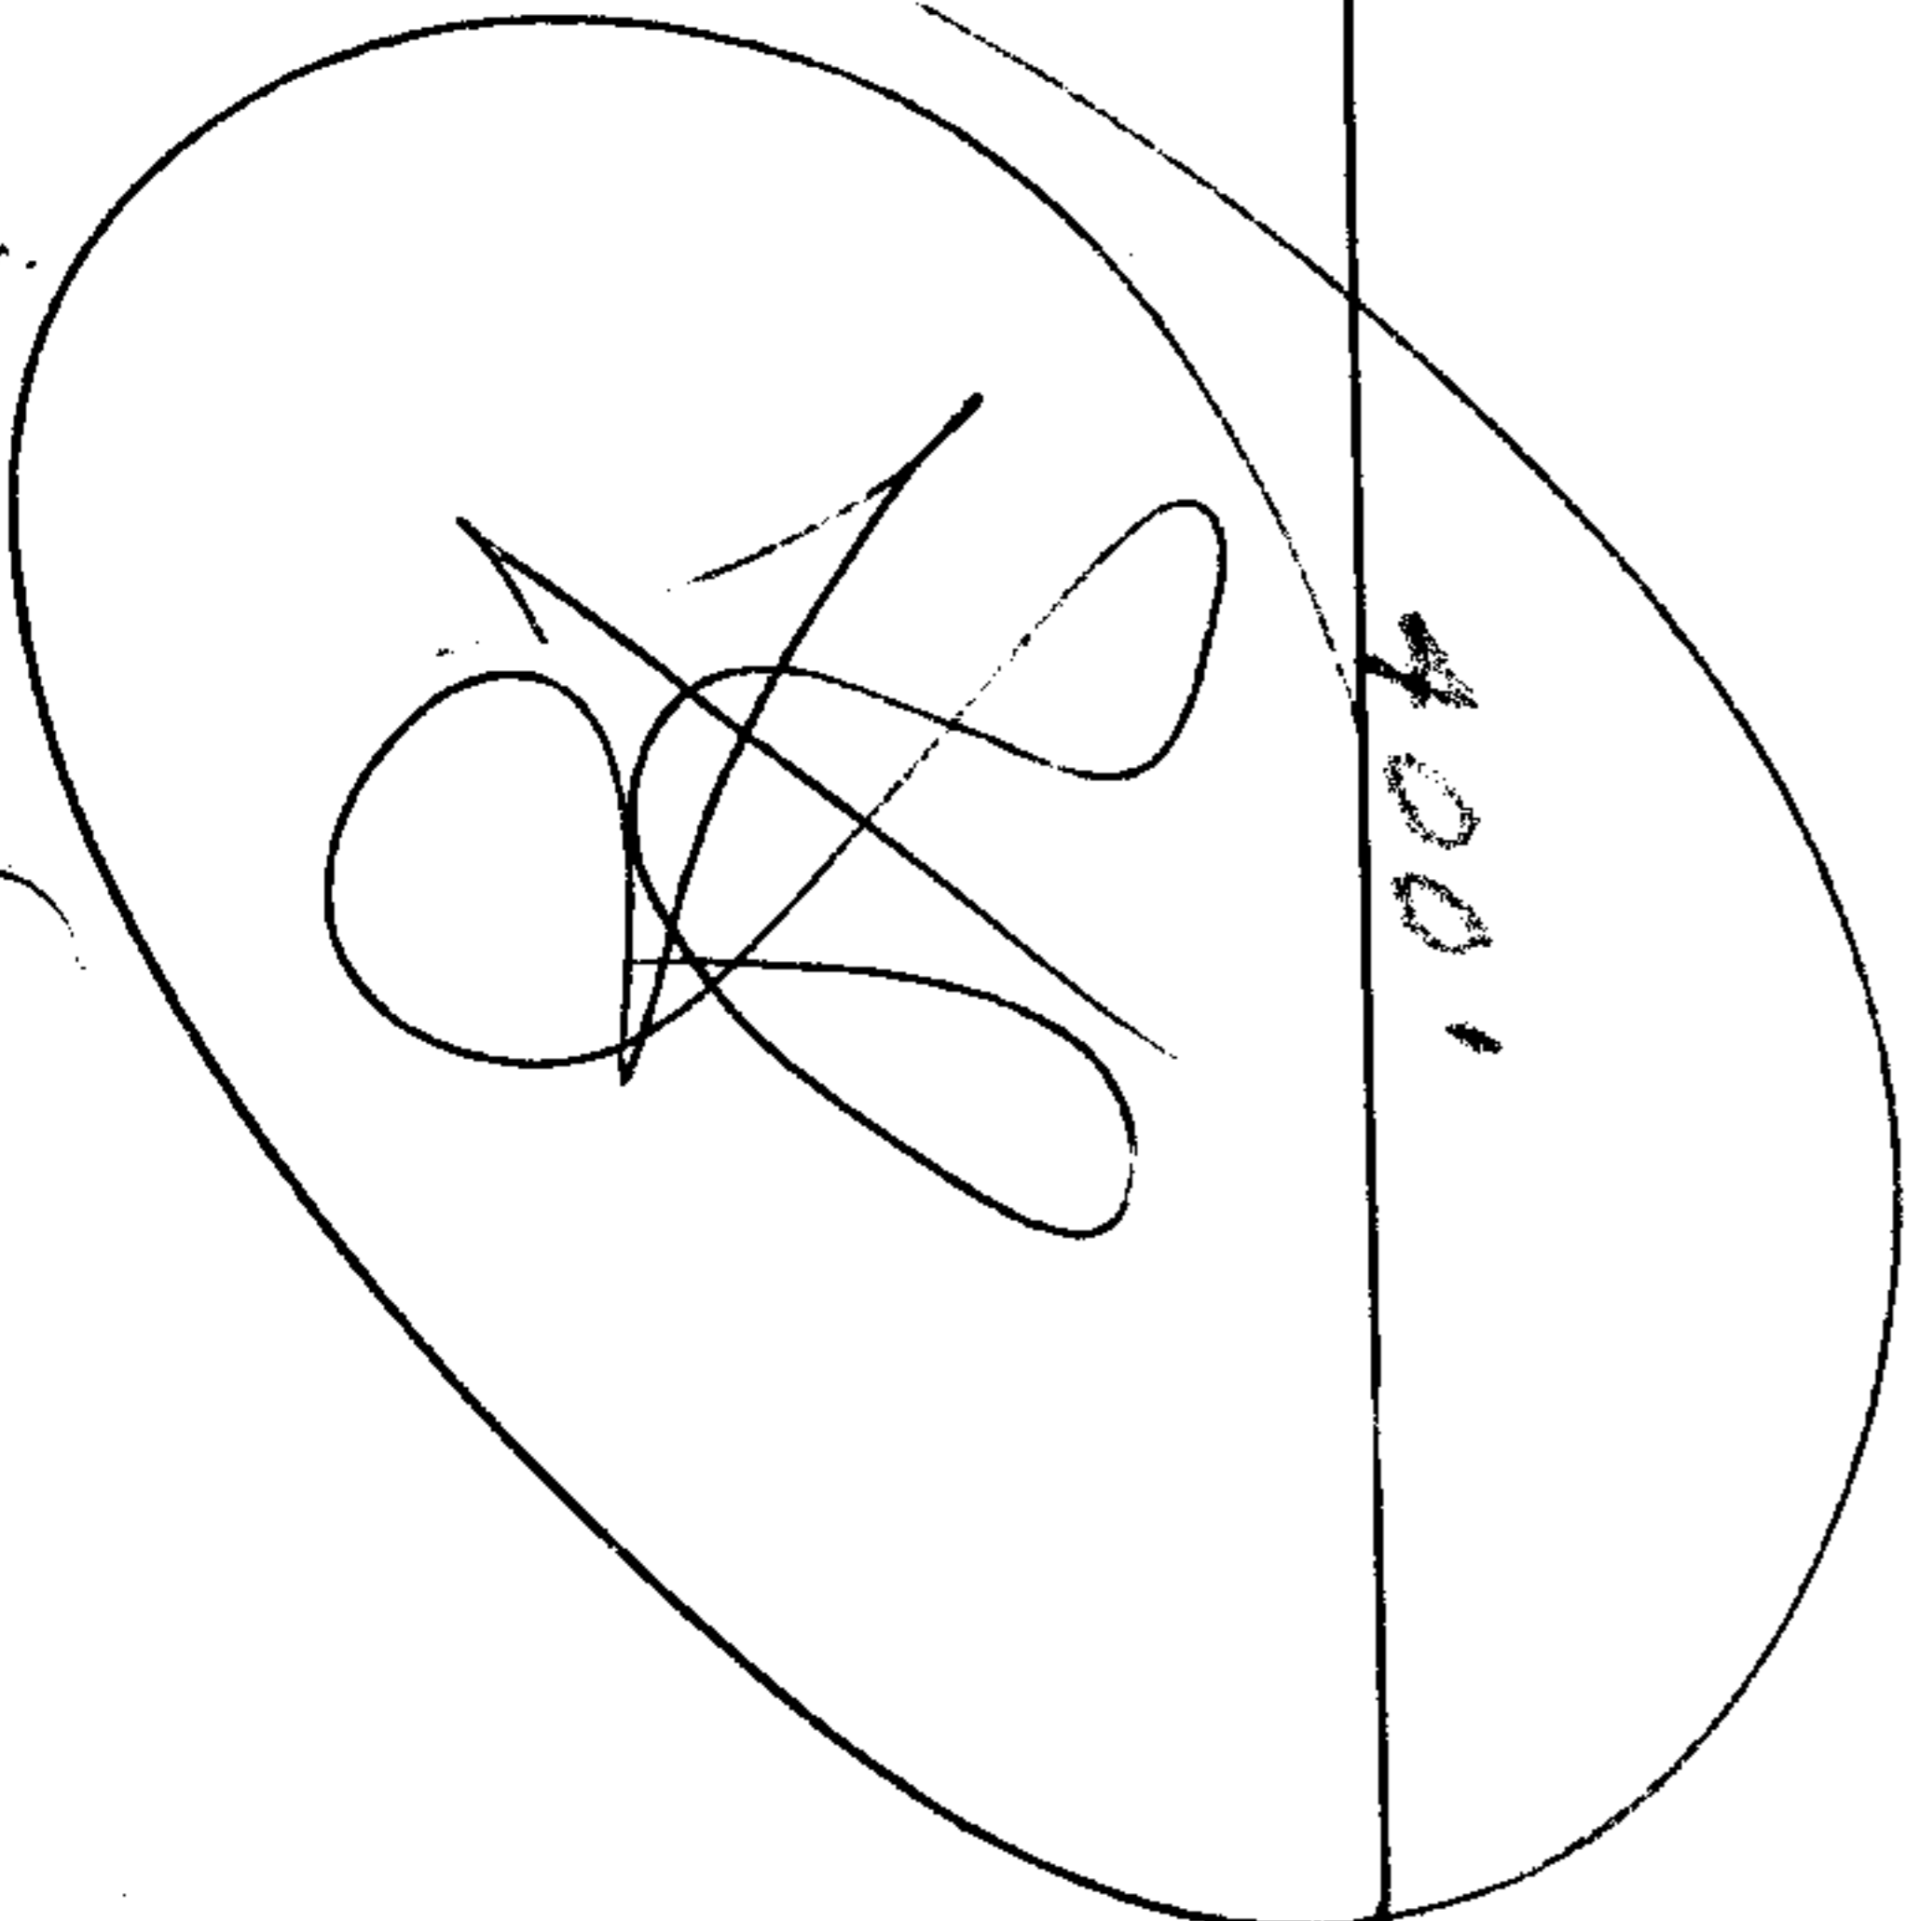

7-15-86 S.S.

APPROVED
LORAIN CO.
MAP DEPT.
DATE 1/29/69
BY P. J. Kellings

67

2418

MAR 1 1969