

RD.

60

RD.

60

170
-005
.49A
125
006
.48A
125
-004
.49A
125
-007
.49A
170

297

788.04

-003
20.85A.

-004
-001
46.50A.
42.50A

2

-002
46.50A.

DUP.


1821.3

92°07'

-002
22.19A. - Map
21.86A. - DUP.

531.8

-003
964.80
4.00A.

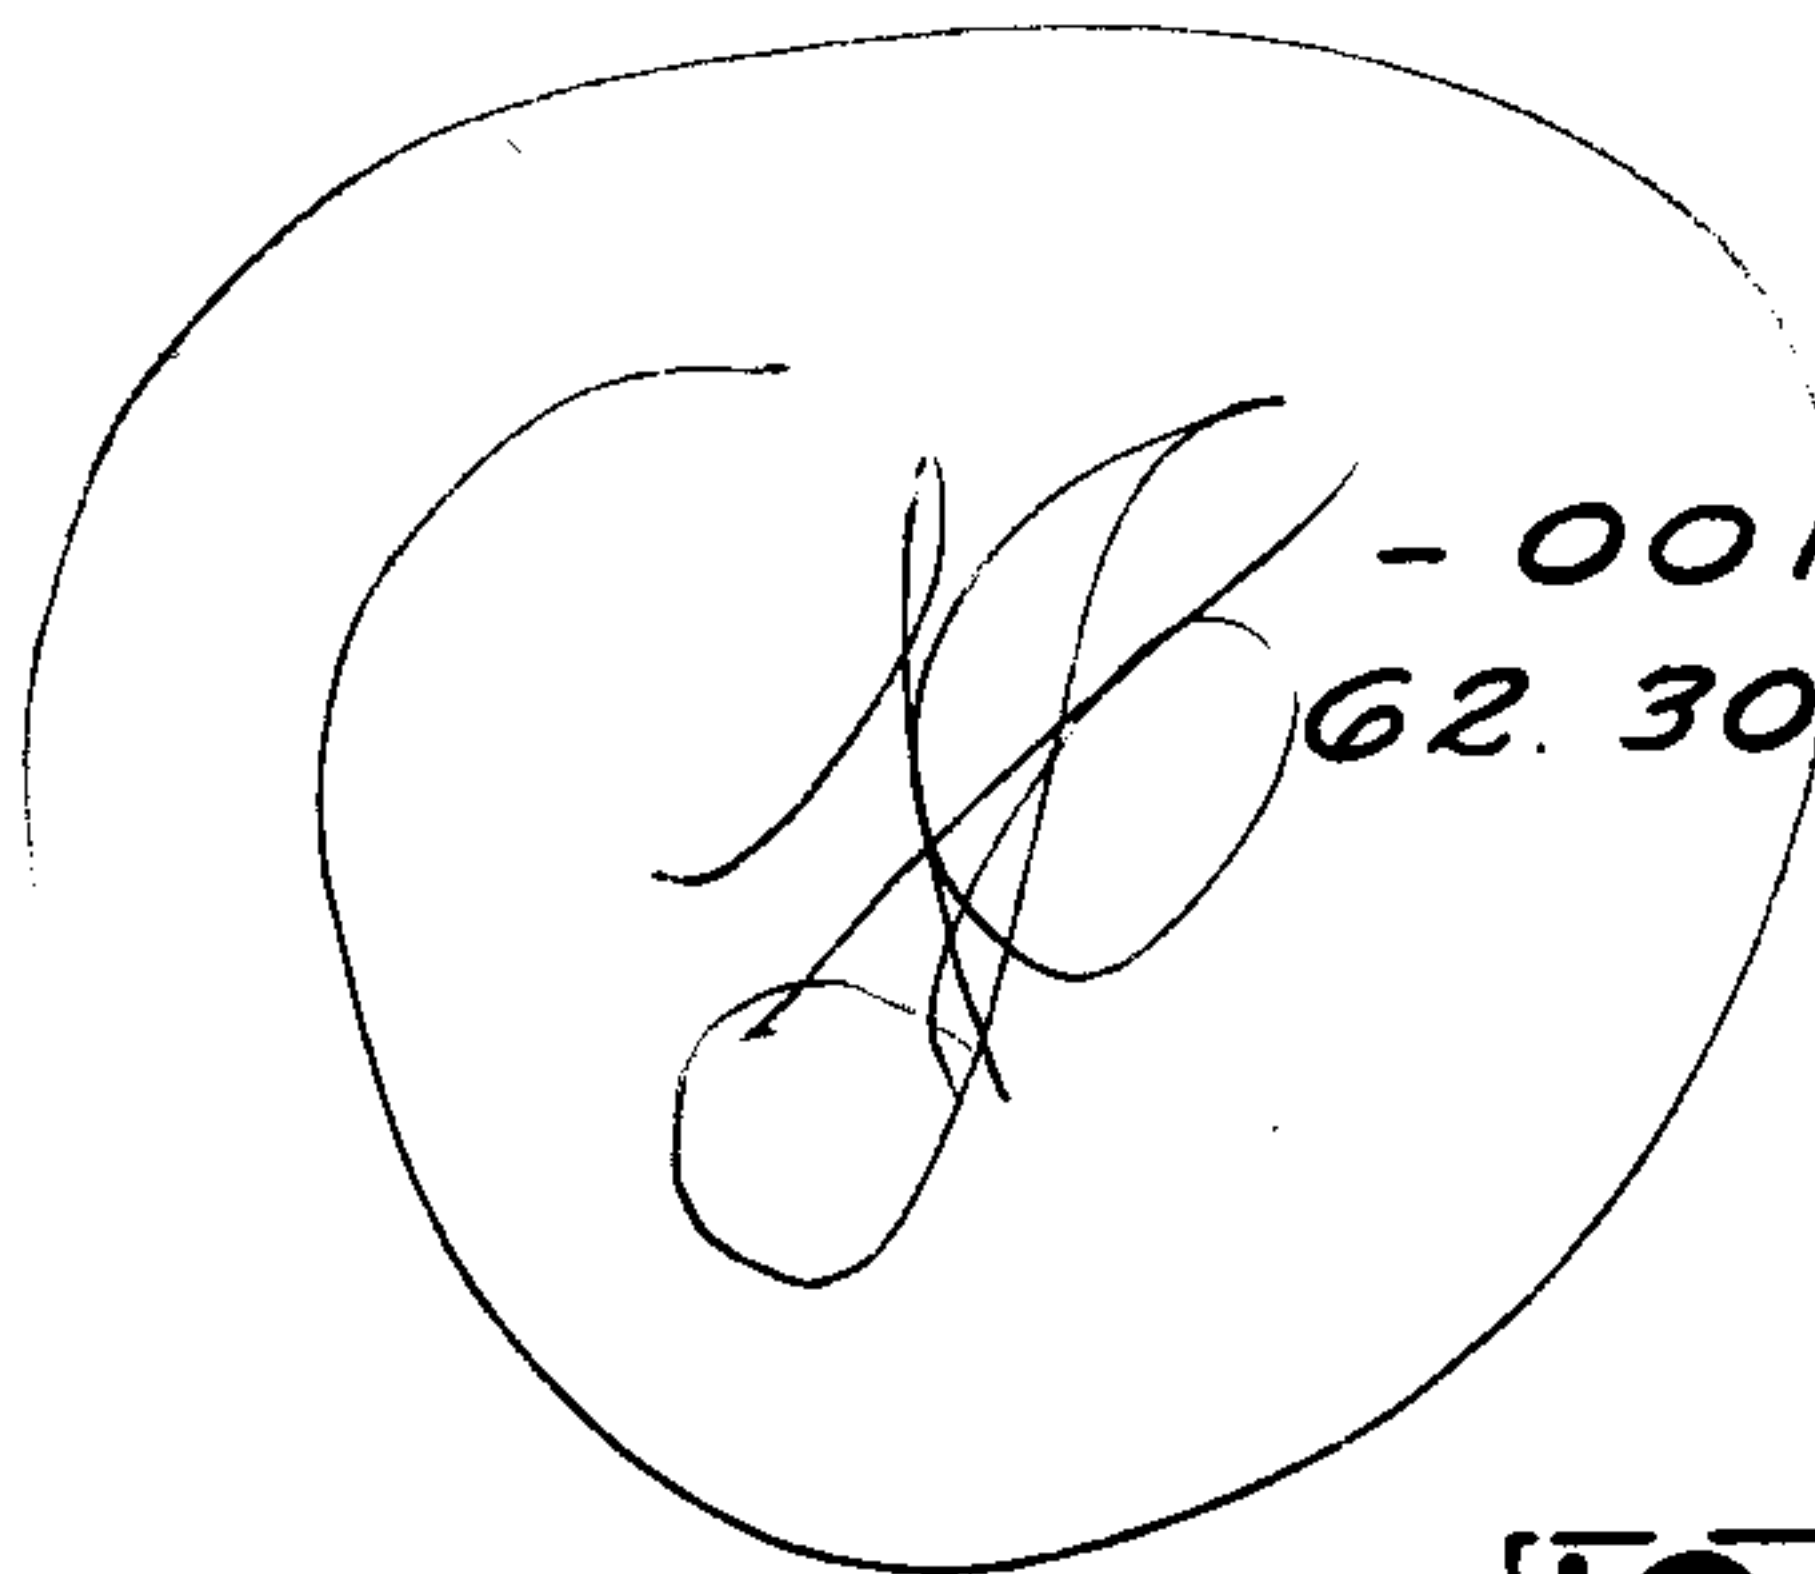

-001
62.30A.

A.

460.3

628.5

T

19

APPROVED
LORAIN CO.
MAP DEPT.

MAR 5 1969

-002
20.00A.

DATE 1/30/69

Pg. 13-A

BY

R. J. Kelling

2420

87°44'

R. R. 2.65A.
-003
1.83A.

-001
1.35A.

500

15

-002

