


30.65A.

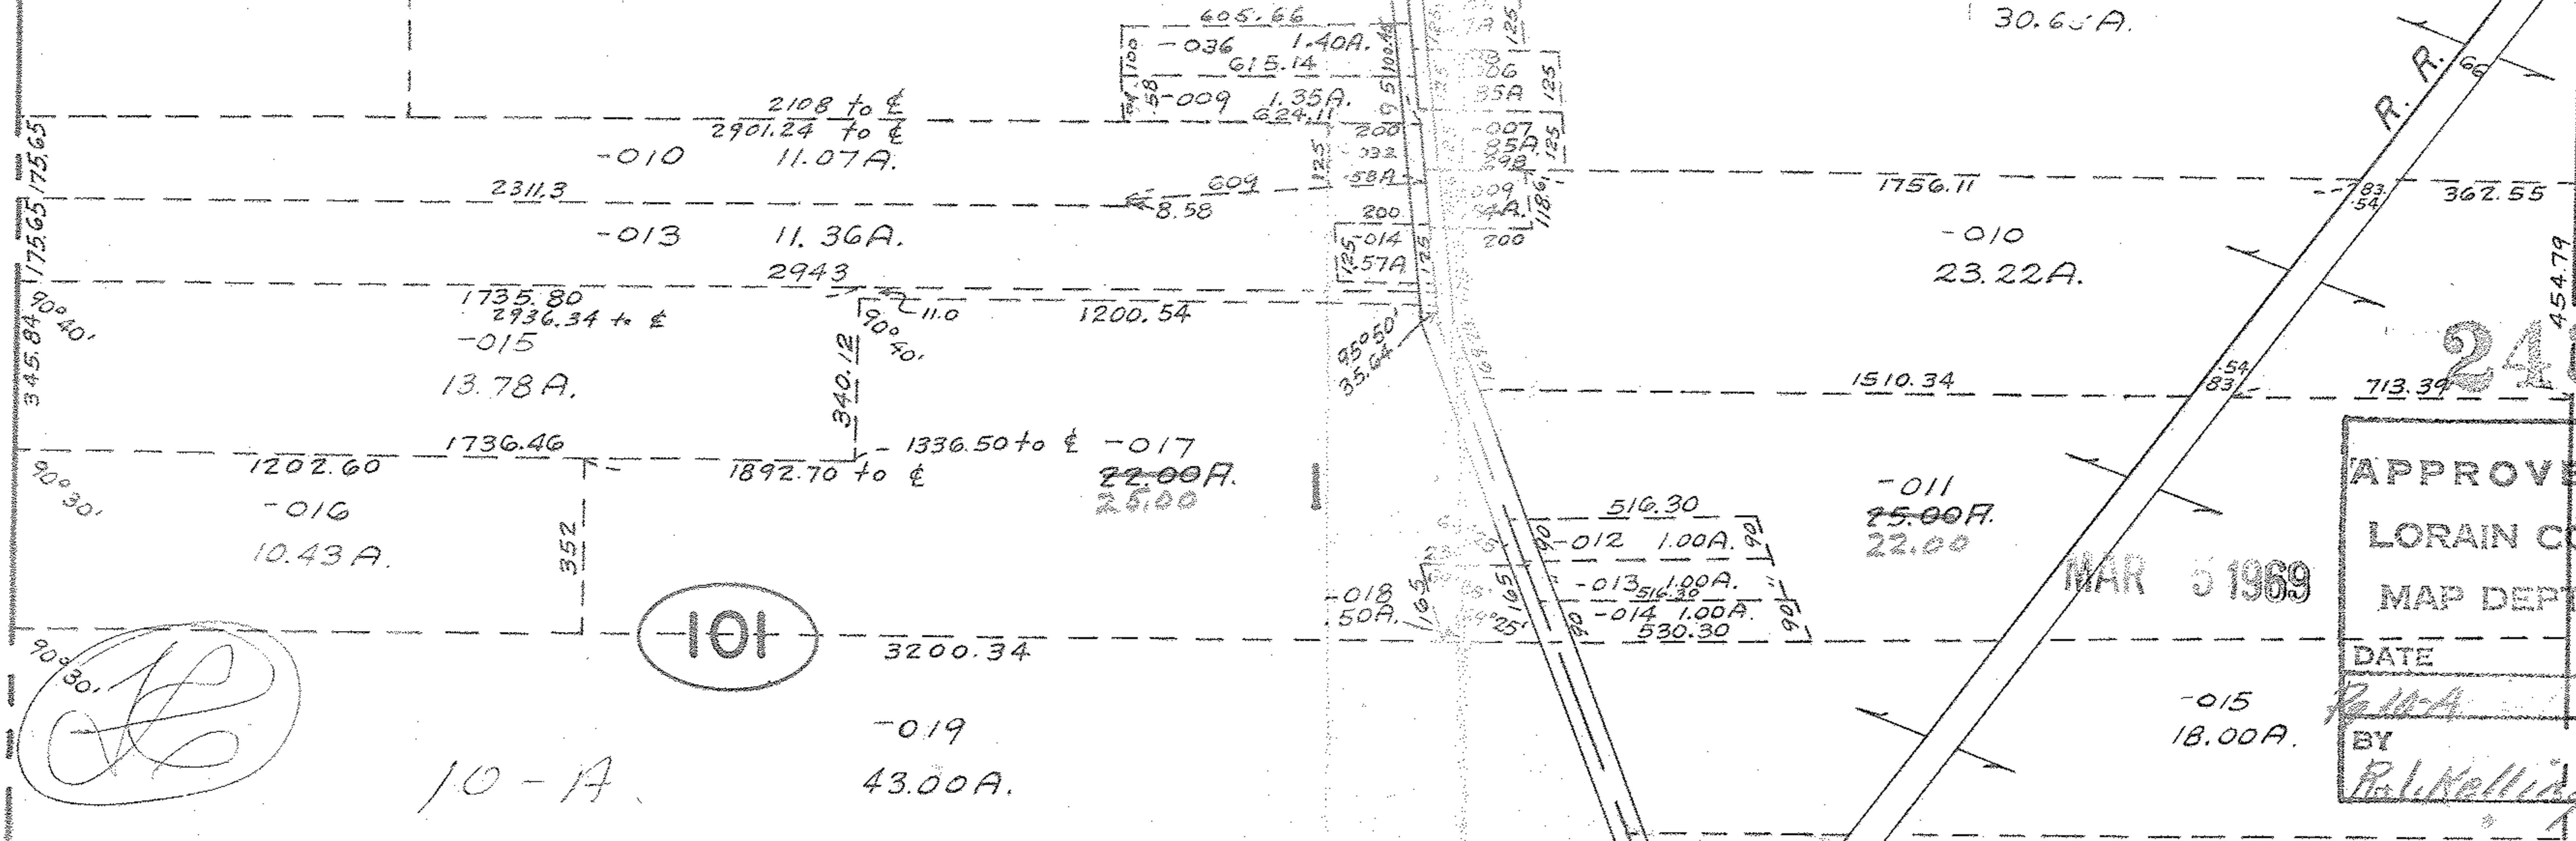

2433

APPROVED	
LORAIN CO.	
MAP DEPT.	
DATE	MAR 5 1969
BY	P. L. Kelling

(Handwritten signature/initials)

10-A