


1018.55 1237.50

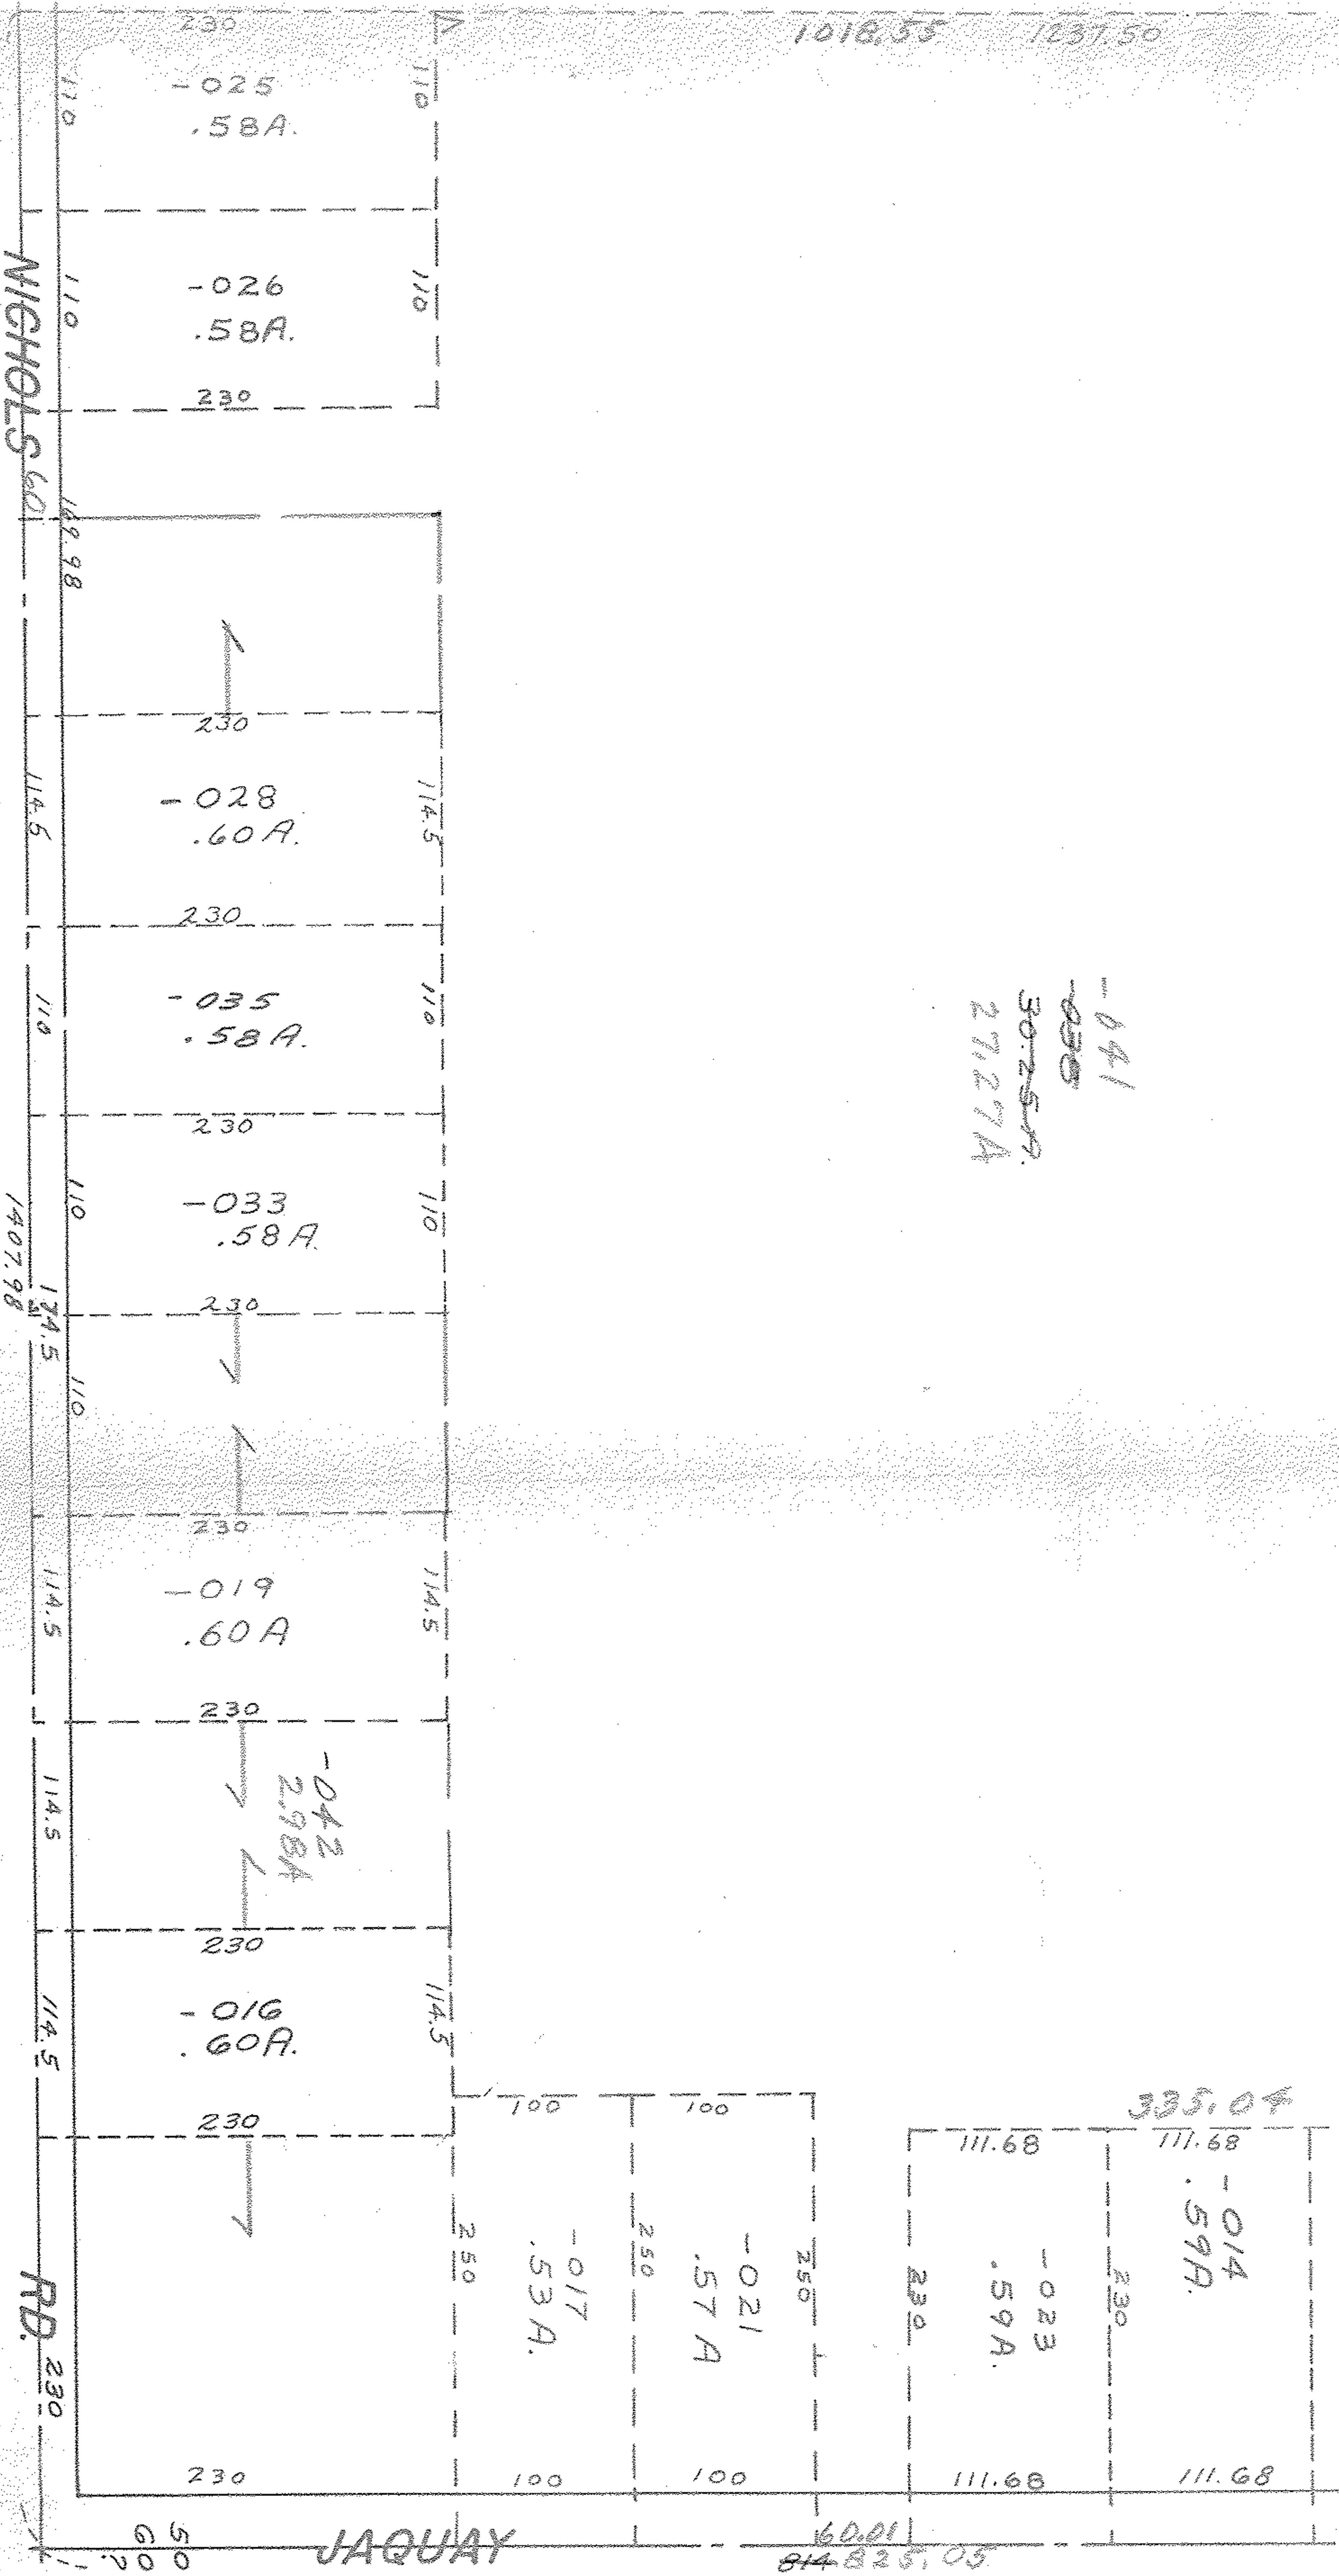


SEE 12-00-064-B

041
030
30-25A
27127A

335.04

JAGUAY

1248.55 Meq. 1237.5 Rec

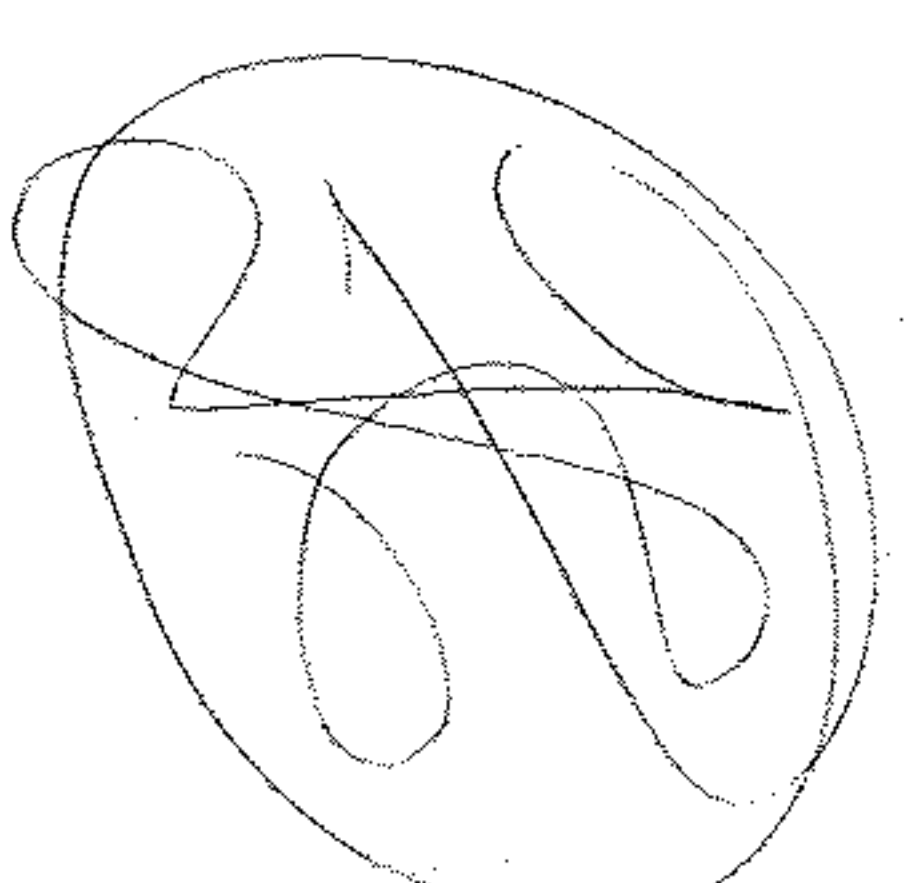

2434
MAR 5 1969

APPROVED
LORAIN CO.
MAP DEPT.

DATE 2/6/69
12-00-064-B

R. J. J.