

SEE 9-

MAR 26 1969

APPROVED  
 LORAIN CO.  
 MAP DEPT.  
 DATE 3/5/69  
 BY R. J. Kelling

4 -001 84.40F. 7-28-86 L.L.

2487

-001  
 25.26A.

-002  
 3.00F.

-008  
 8.08A.

-012  
 12.85A.

-006  
 2.98F.

17

3F.

-007  
 2.45F.

415.22

409.08

516.07

1088

852

009

63F.35

010 2.10F.

581.60

582.19

-010  
 17.64A.


-004  
 18.00F.

8

-005  
 18.00F.

-006  
 18.00F.

Pt. -007  
 Pt. -007  
 18.00F.

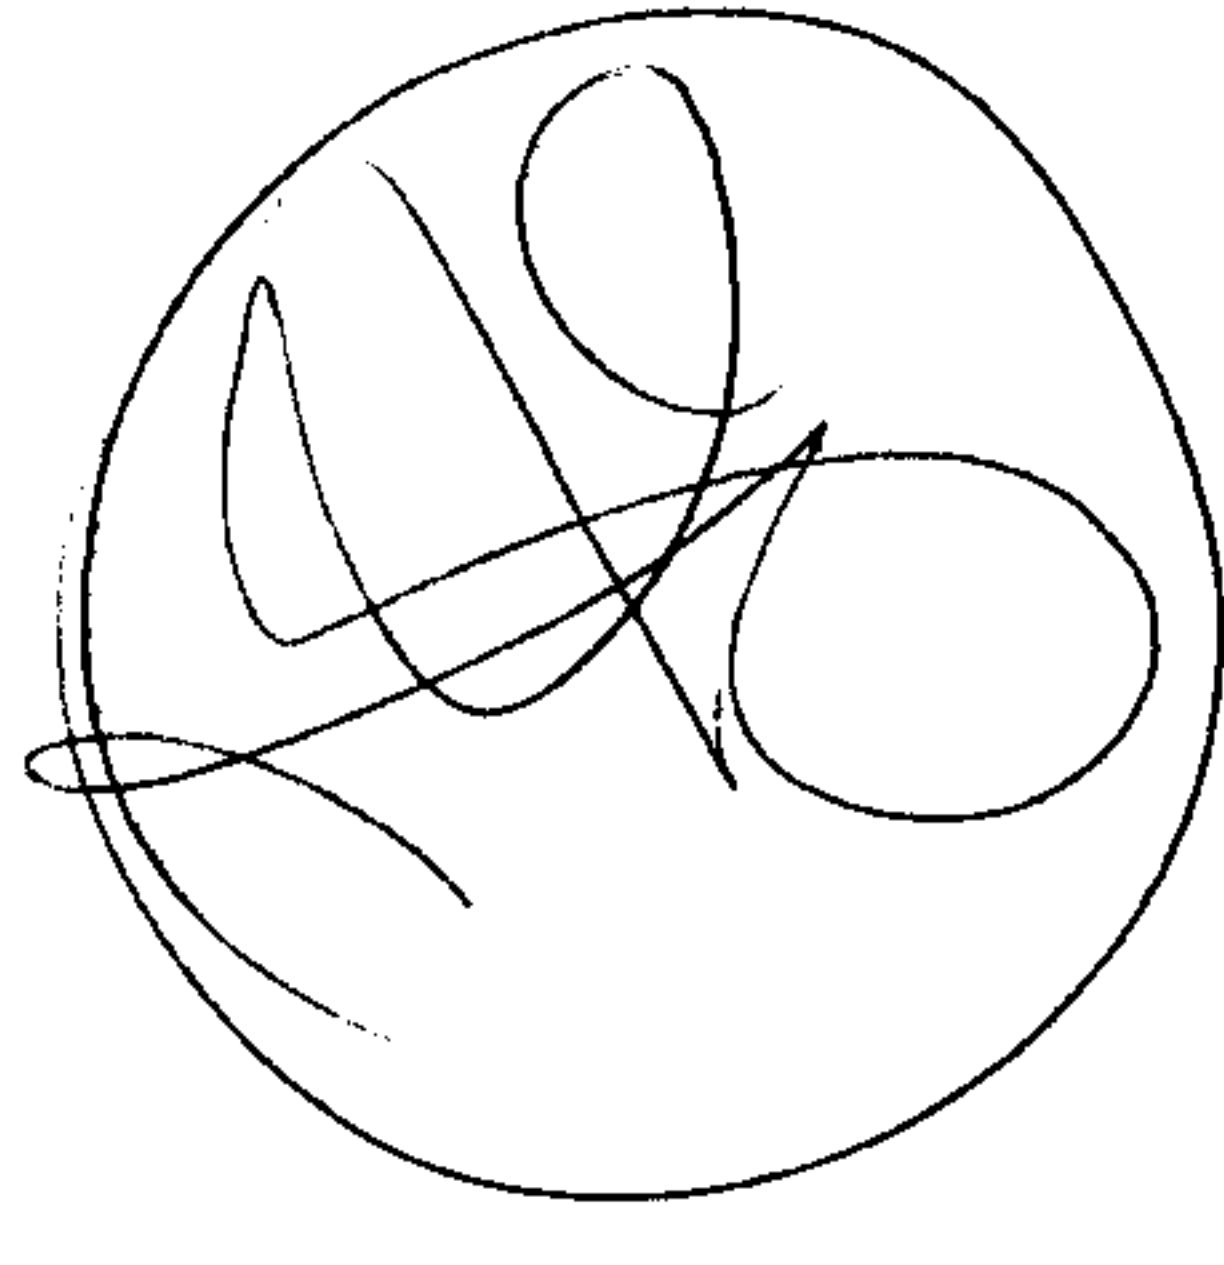

3

-010  
~~-006~~  
~~77.00F.~~  
 76.69A.

528

30

940

287

287

