
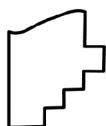


25-00839

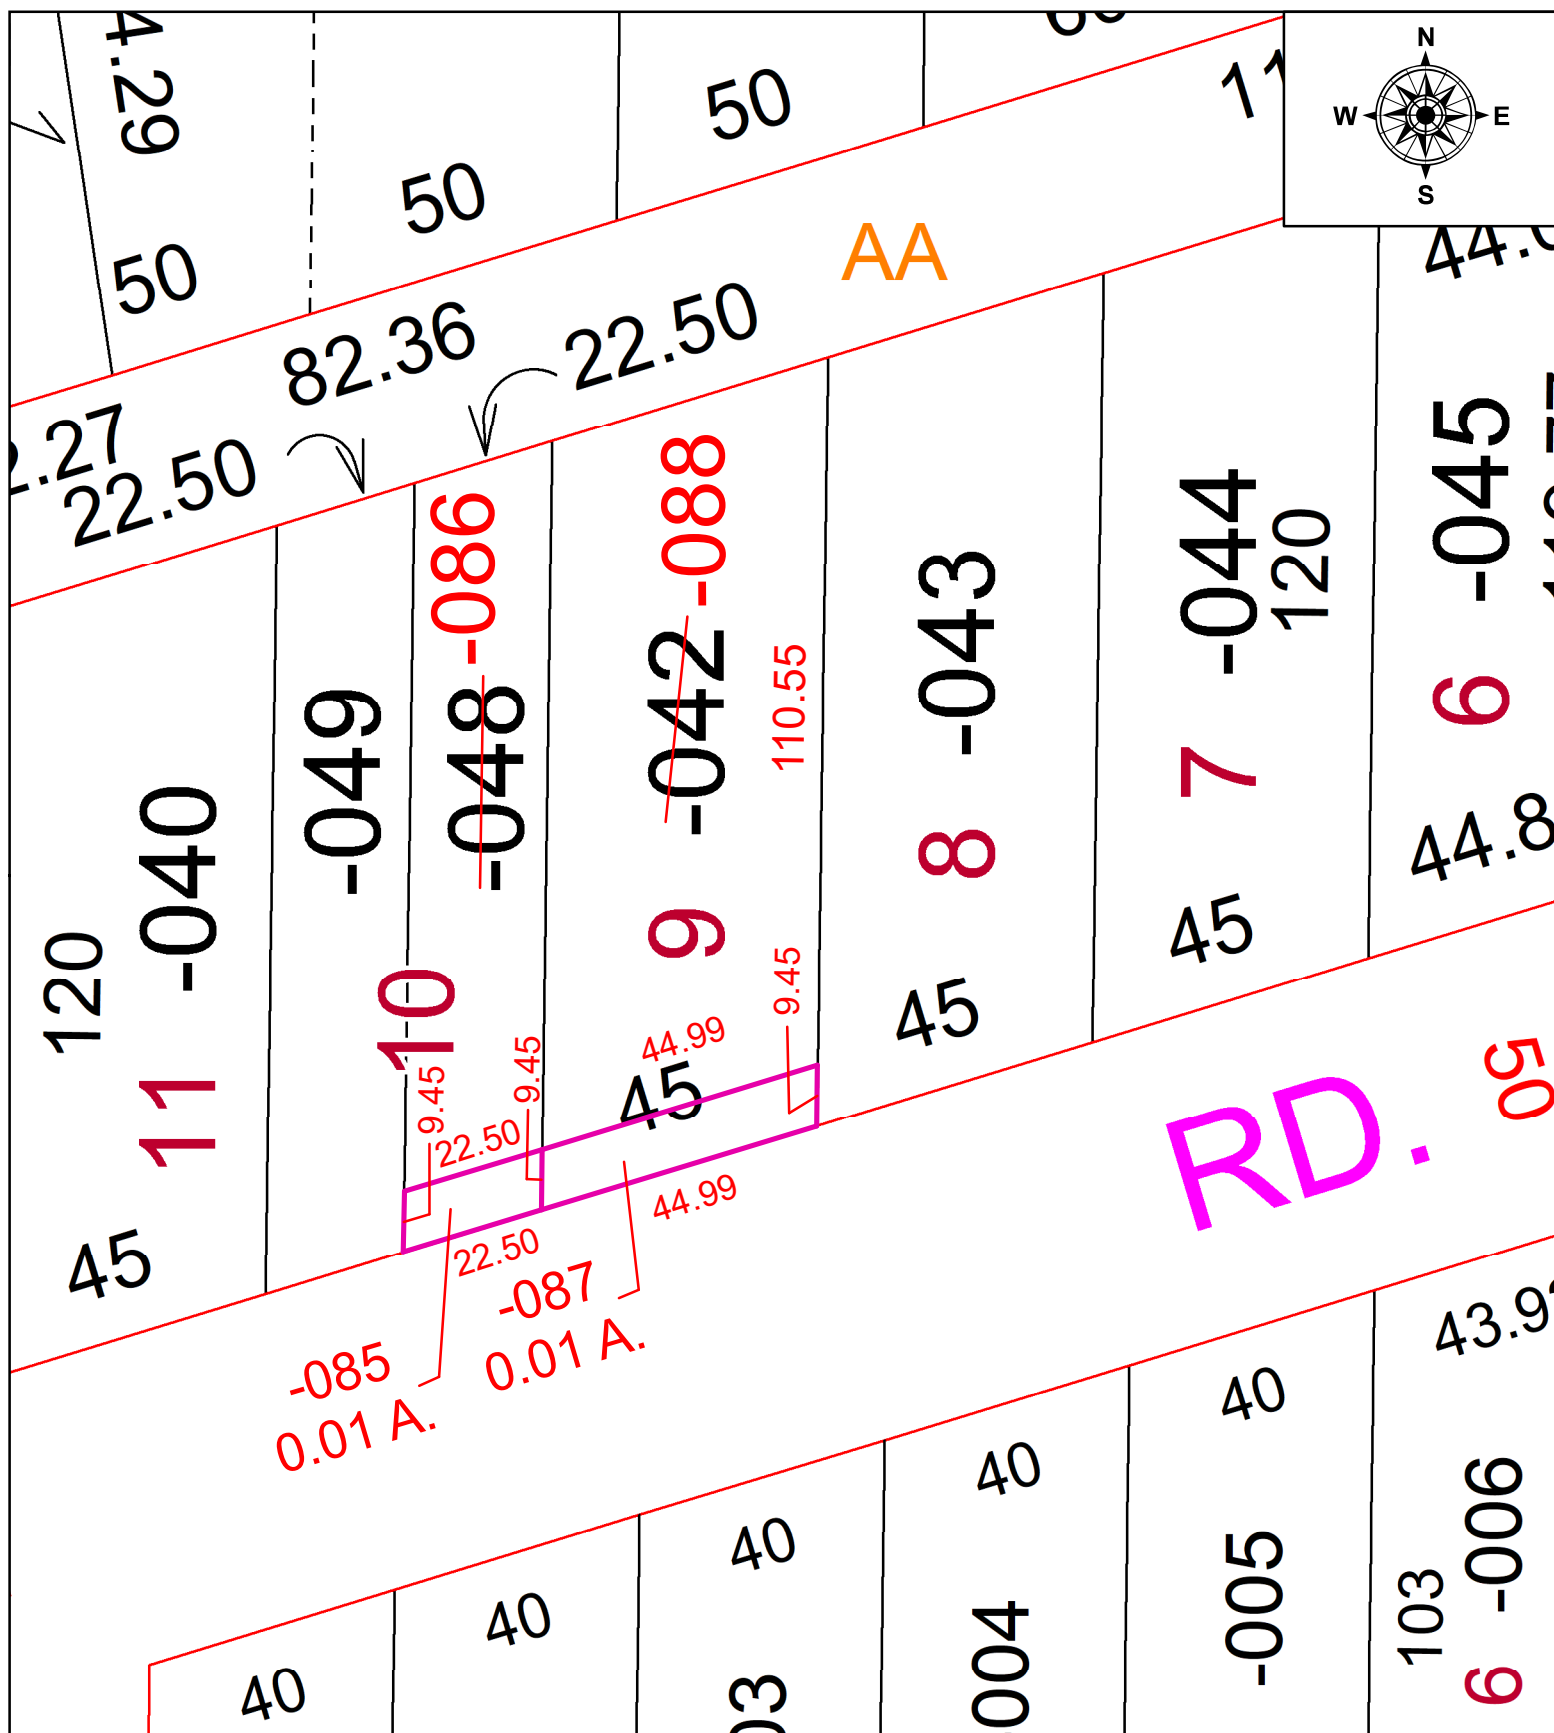

SPLITS/DEEDS PROCESSED

LORAIN COUNTY TAX MAP DEPARTMENT
226 MIDDLE AVE. ELYRIA, OH

SURVEYED BY: _____ AMY KELLY

CLOSURE: 1: INF

MAP PAGE(S): 03-00-038

APPROVED BY: TJS **DATE:** 4/1/2025

SCALE: 1" = 30' **PRIOR INSTRUMENT:** 2011-0394344