

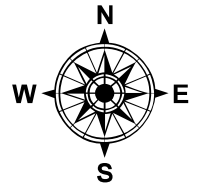


25-00846

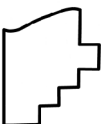

107

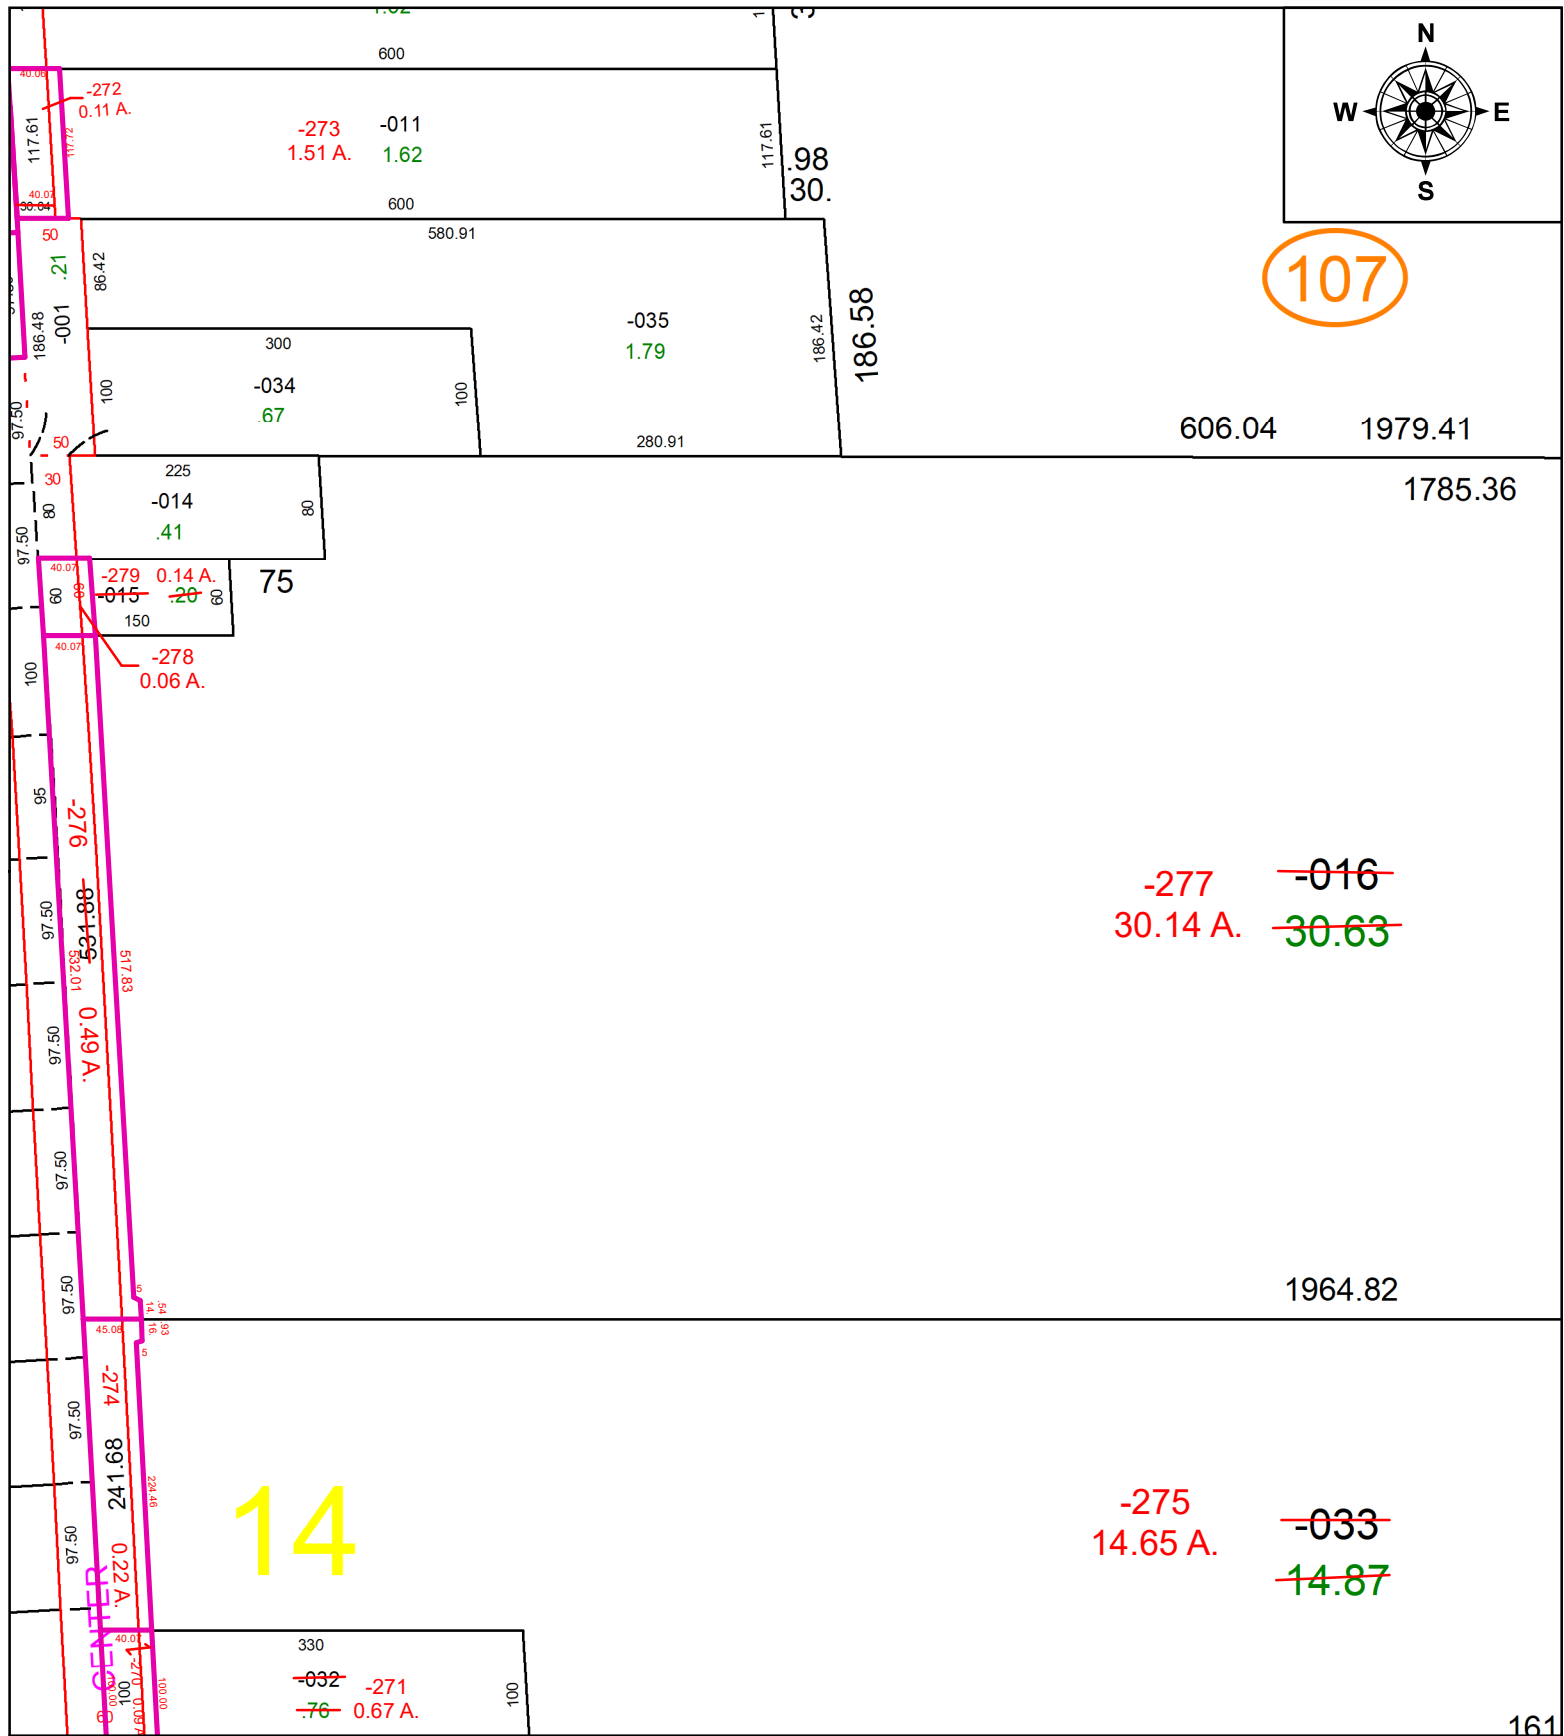

SCALE: 1" = 200' **PRIOR INSTRUMENT:** 2015-0558238