
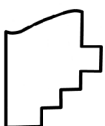


PARENT PARCEL: 04-00-014-107-031
CHILD PARCEL: 04-00-014-107-282 & -283 23-WD LOR-83-1676
STARTING POINT: I.P. MON. BOX, EAST ROW OF CENER RD (S.R. 83) & CL WINDEMERE WAY

25-00850

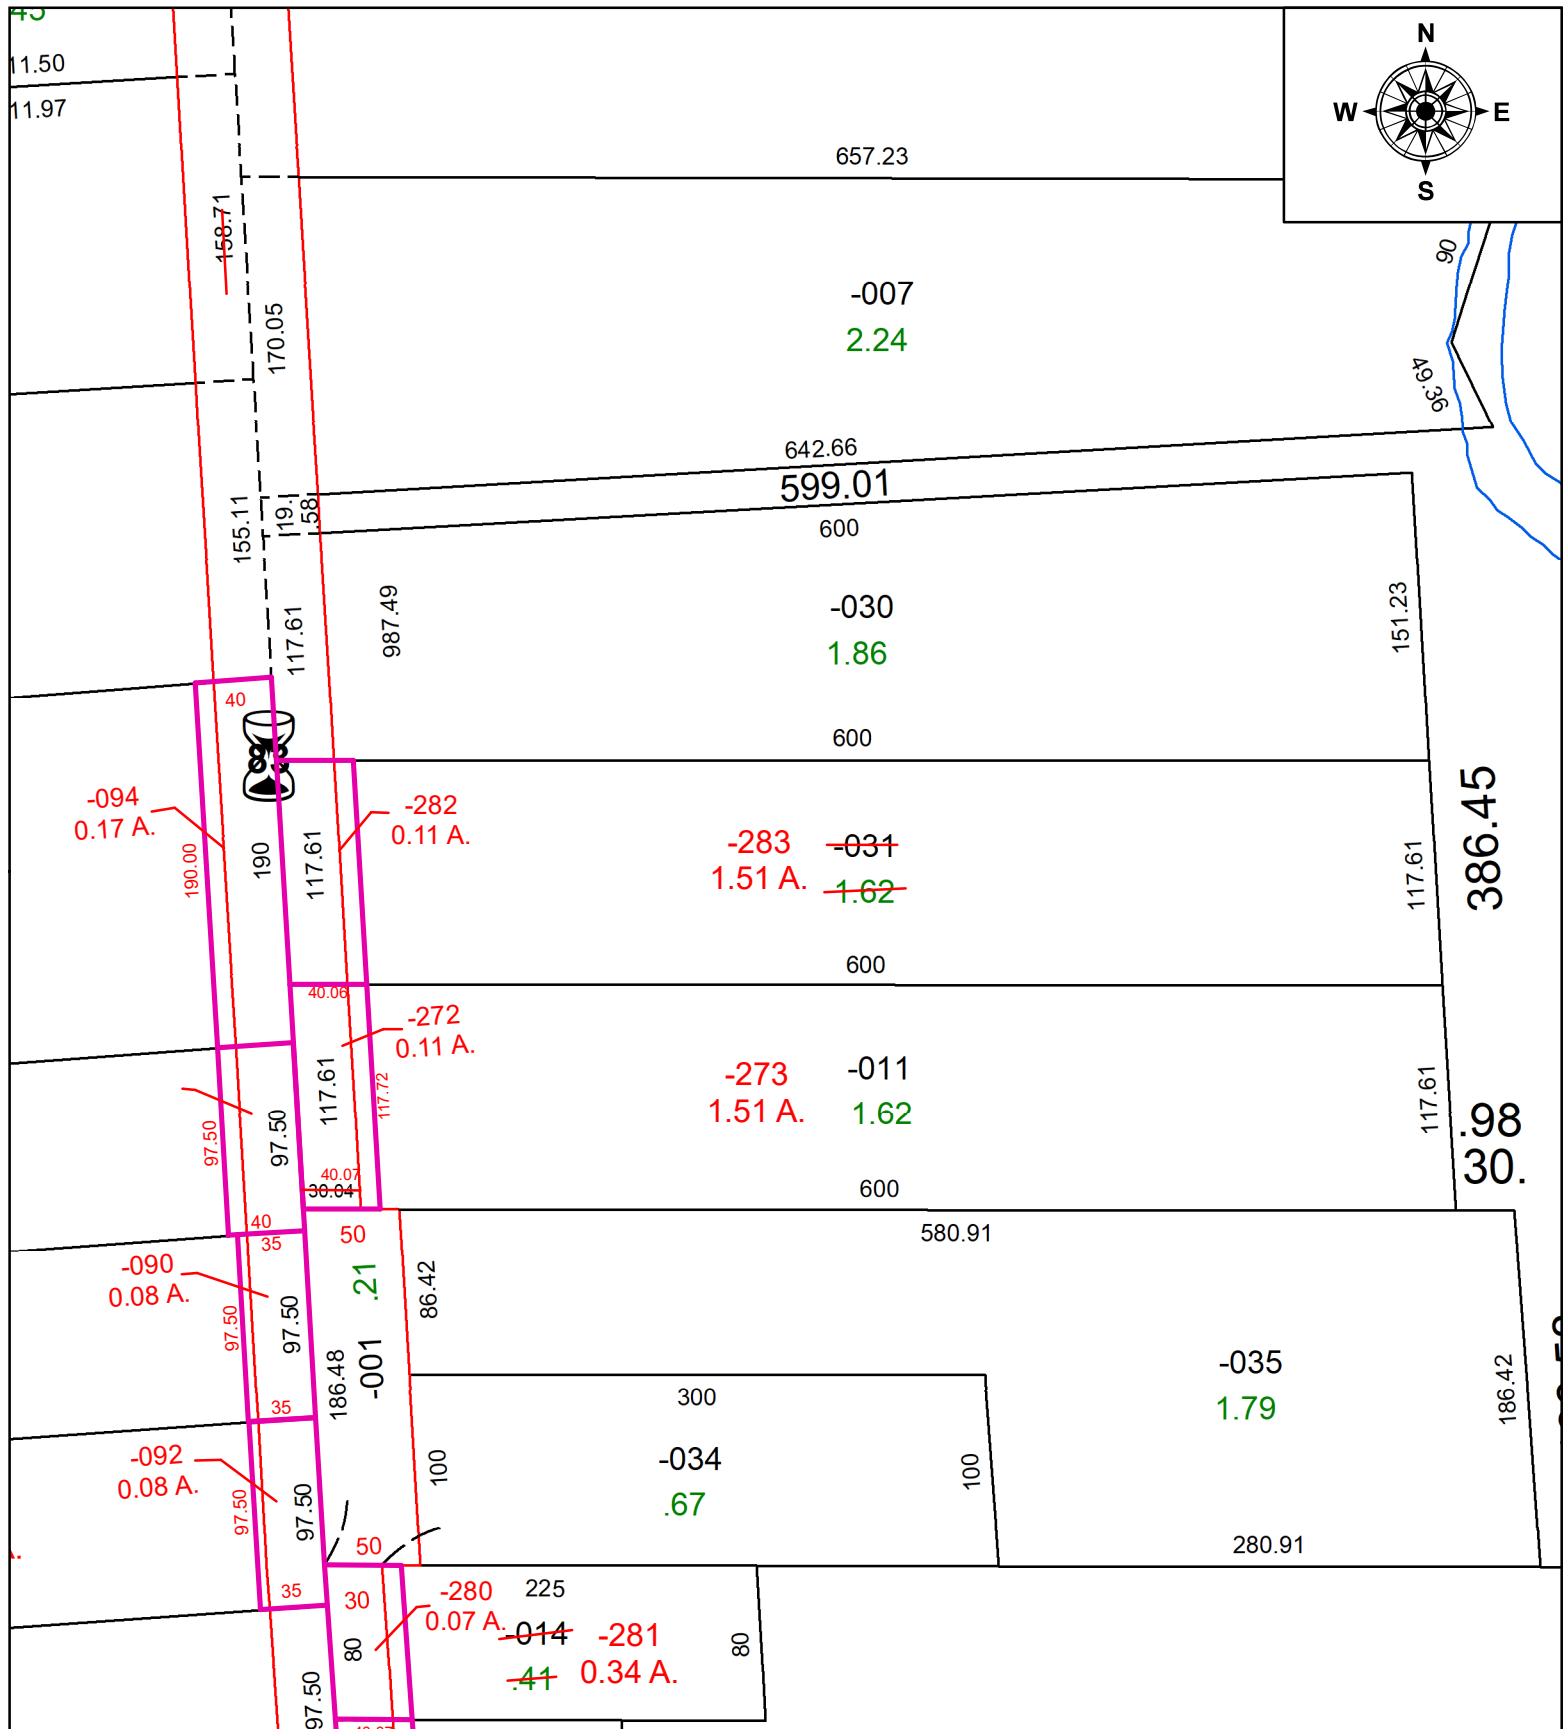

SPLITS/DEEDS PROCESSED
LORAIN COUNTY TAX MAP DEPARTMENT
226 MIDDLE AVE. ELYRIA, OH

SURVEYED BY: DONALD SHEEHY
CLOSURE: 1: INF
MAP PAGE(S): 04-00-014
APPROVED BY: TJS DATE: 4/11/2025
SCALE: 1" = 100' PRIOR INSTRUMENT: 2008-0261671