
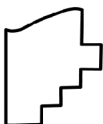


STARTING POINT: MON. BOX, CL OF WYNDEMERE WAY & EAST R.O.W. OF CENTER RD. (S.R. 83)

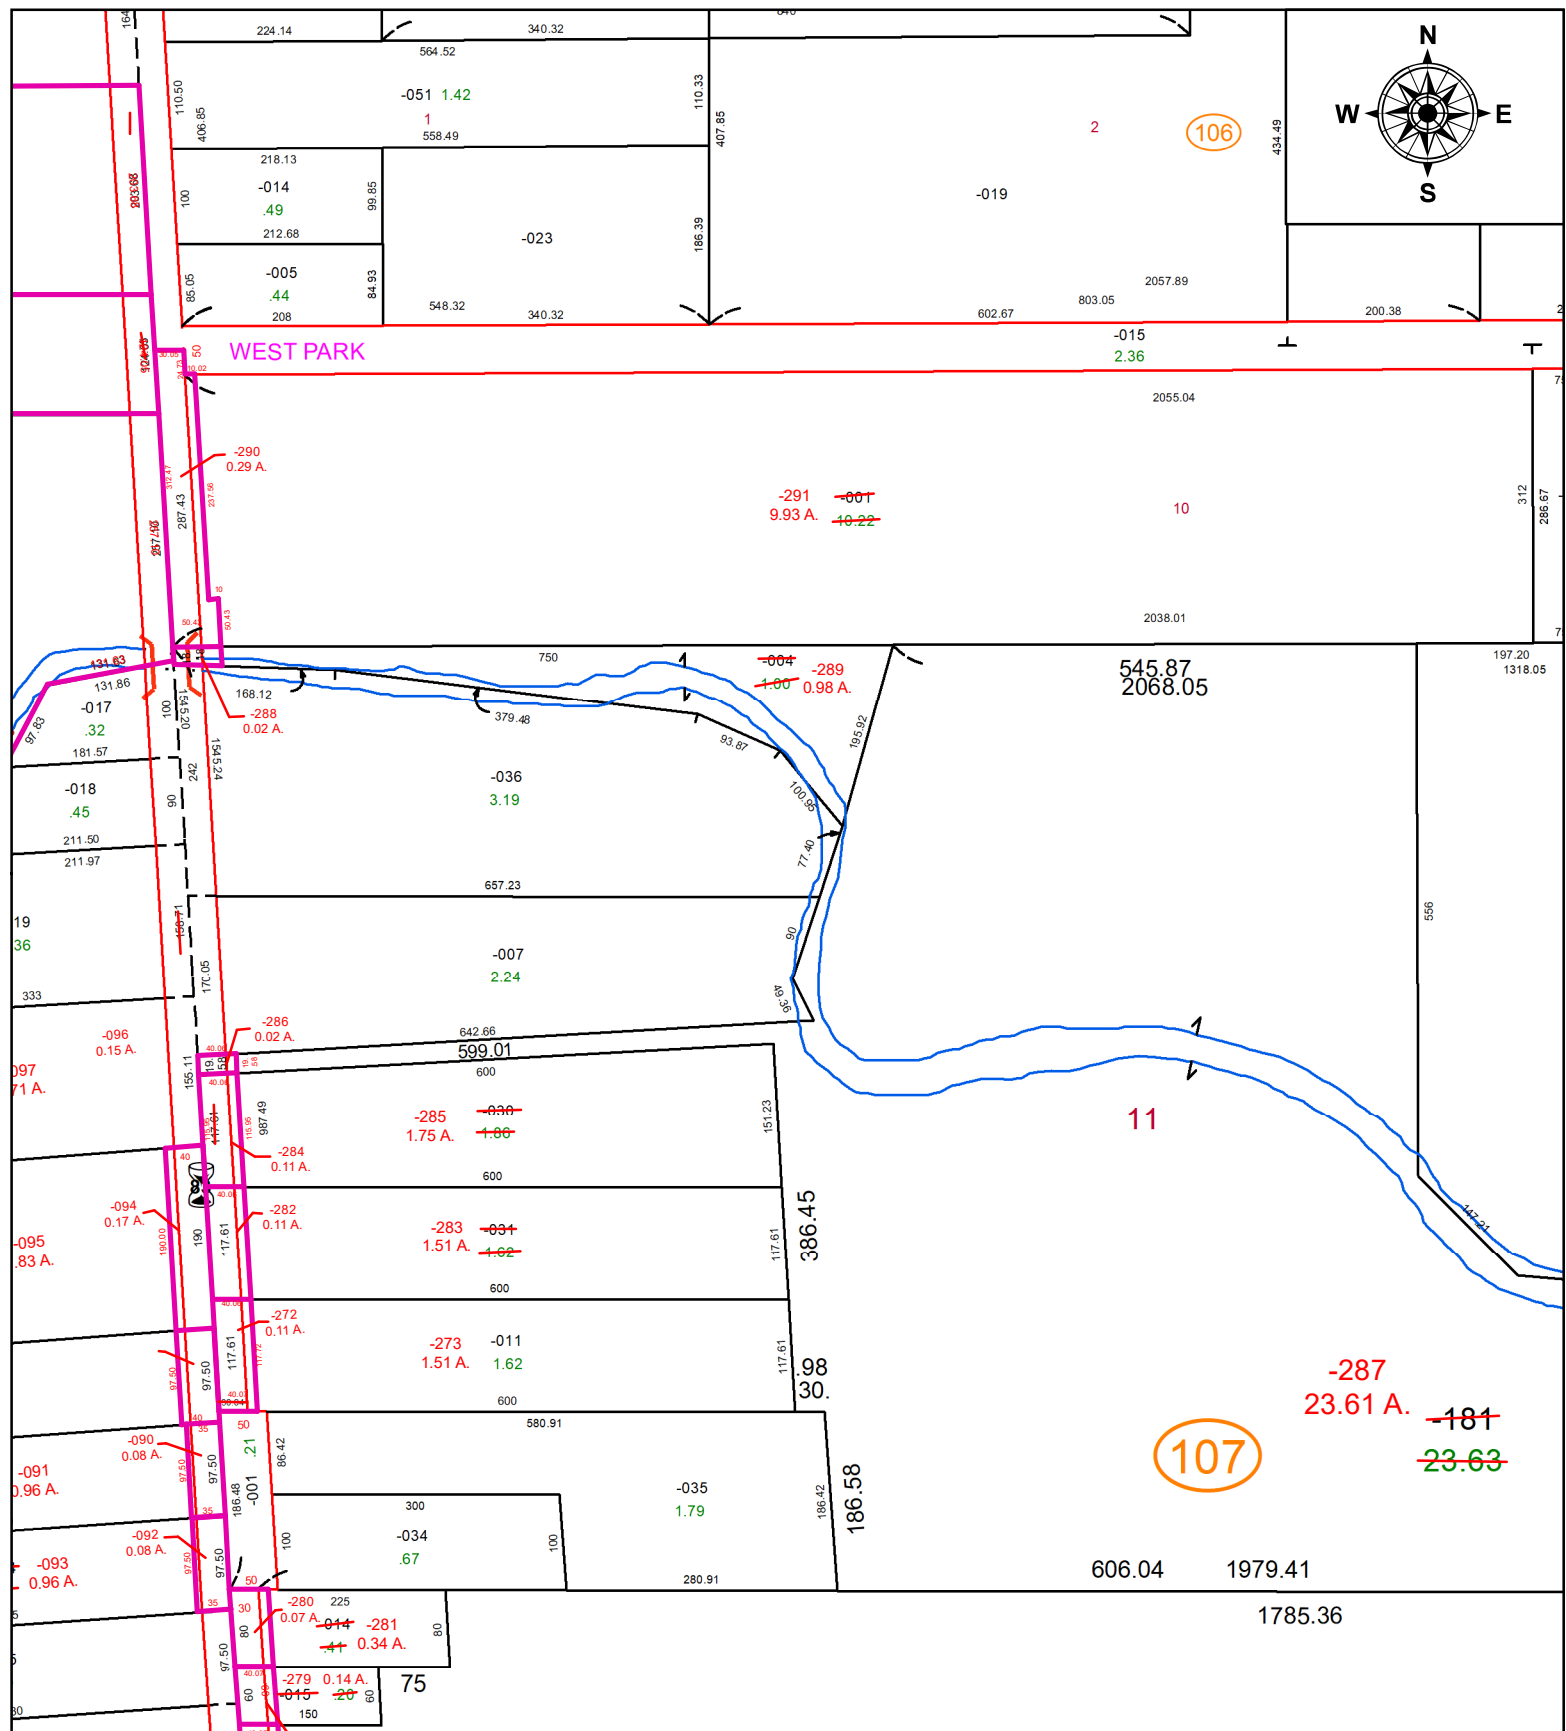

LORAIN COUNTY TAX MAP DEPARTMENT
226 MIDDLE AVE. ELYRIA, OH

SCALE: 1" = 200' **PRIOR INSTRUMENT:** 1999-0599327