
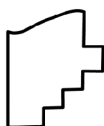


STARTING POINT: 1" I.P. FD. CL OF DETROIT STA. 180+40.21 LOR-SR-254-05.66

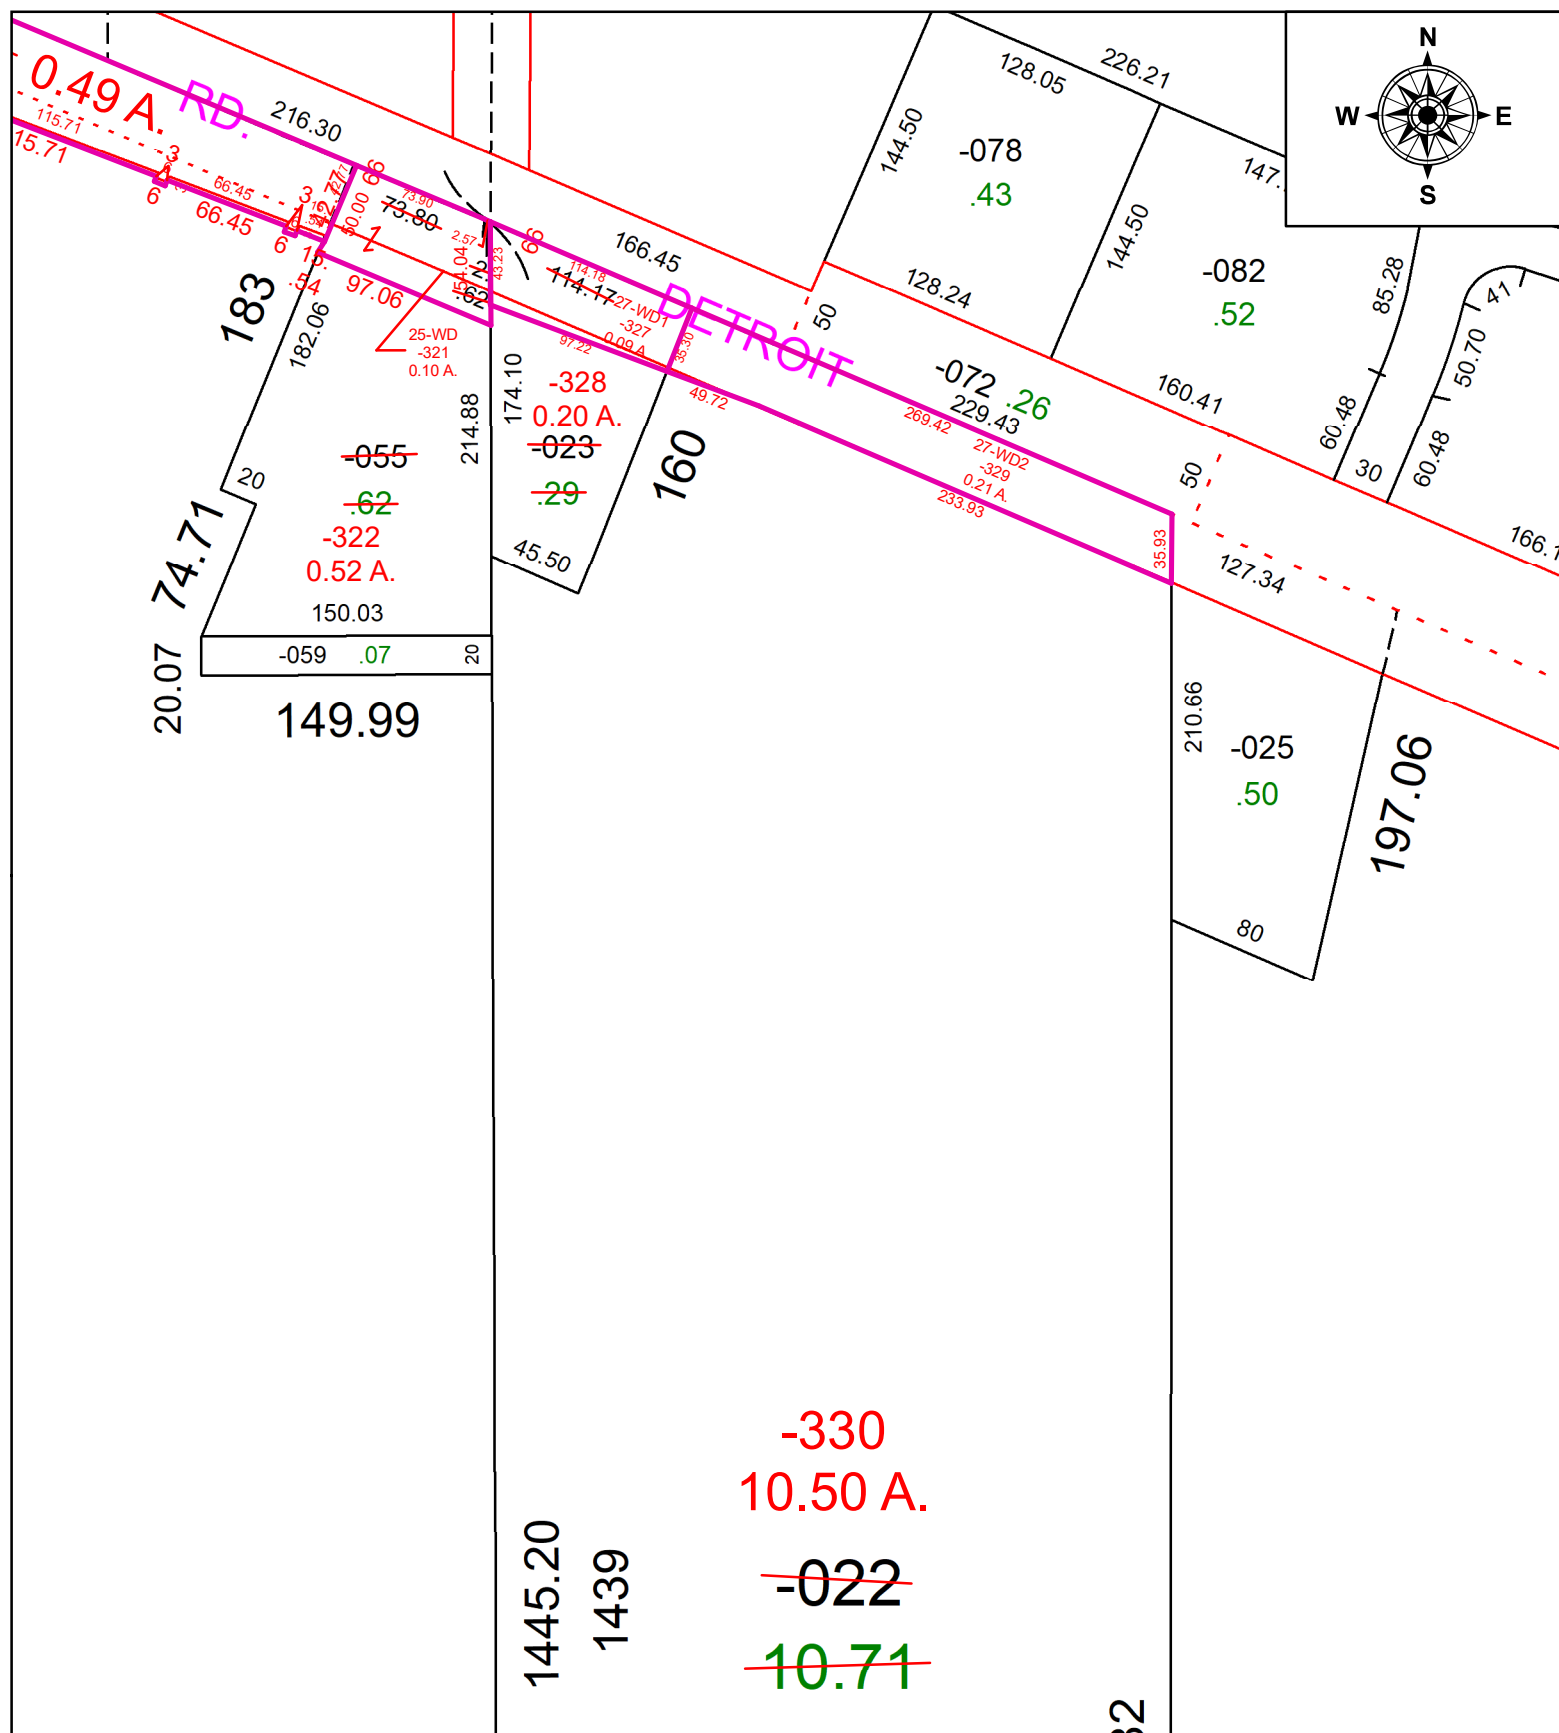

LORAIN COUNTY TAX MAP DEPARTMENT
226 MIDDLE AVE. ELYRIA, OH

SCALE: 1" = 100' **PRIOR INSTRUMENT:** 2007-0207218