


PARENT PARCEL: 04-00-014-107-007
CHILD PARCEL: 04-00-014-107-292 & -293 27-WD LOR-83-16.76
STARTING POINT: 1" I.P. FD.MON. BOX CL OF CENTER RD. (S.R. 83) & EAST R.O.W. OF WYNDEMERE WAY.

25-00858

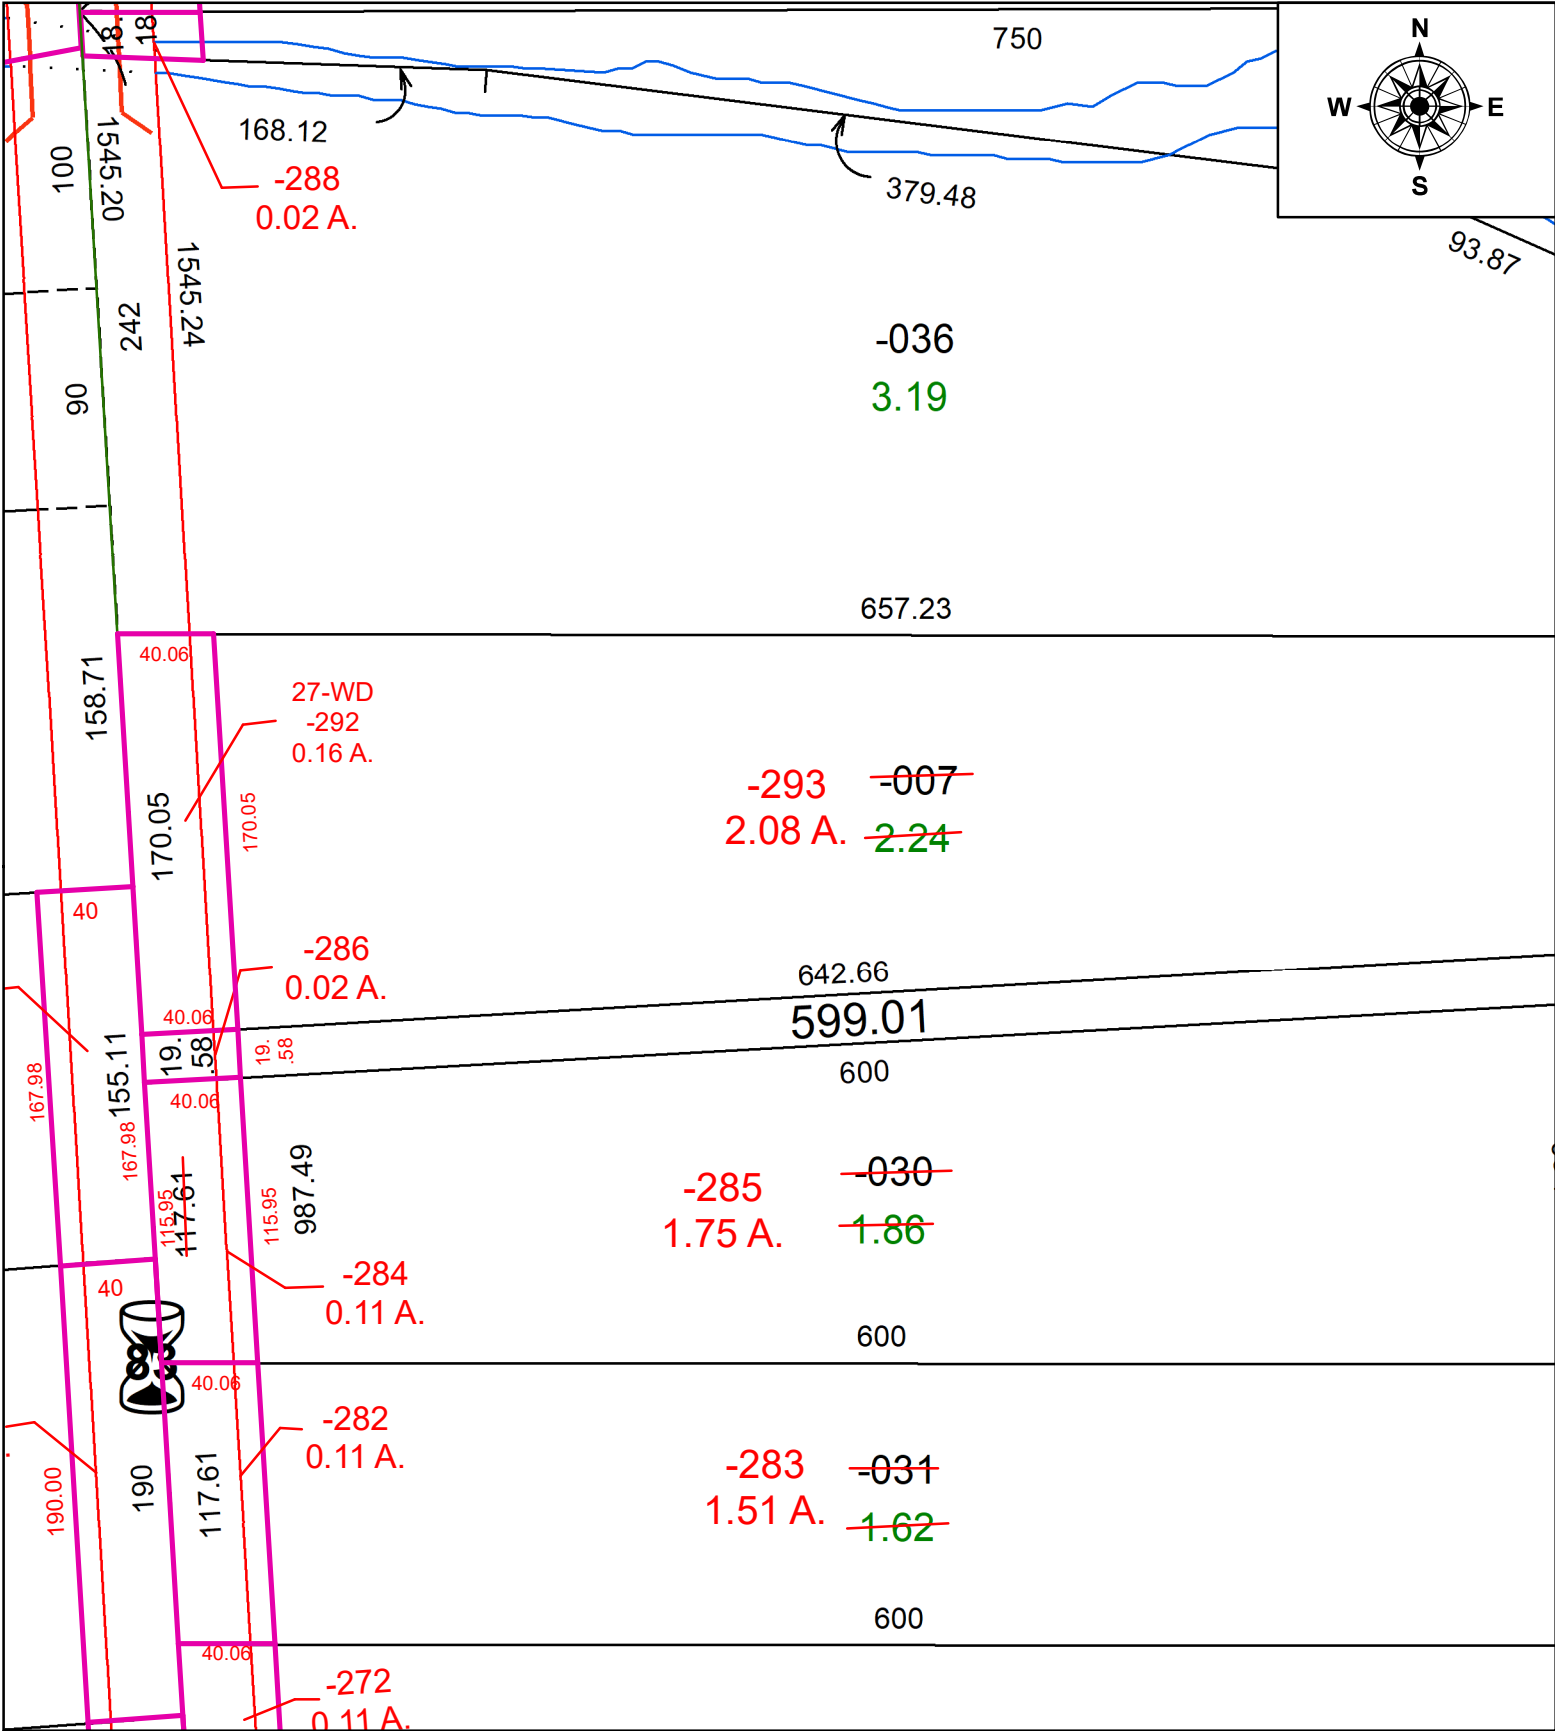

 **SPLITS/DEEDS PROCESSED**
LORAIN COUNTY TAX MAP DEPARTMENT
226 MIDDLE AVE. ELYRIA, OH

SURVEYED BY: DONALD SHEEHY
CLOSURE: 1: INF
MAP PAGE(S): 04-00-014
APPROVED BY: TJS DATE: 5/2/2025
SCALE: 1" = 80' PRIOR INSTRUMENT: 2024-0011541