
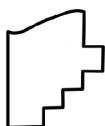
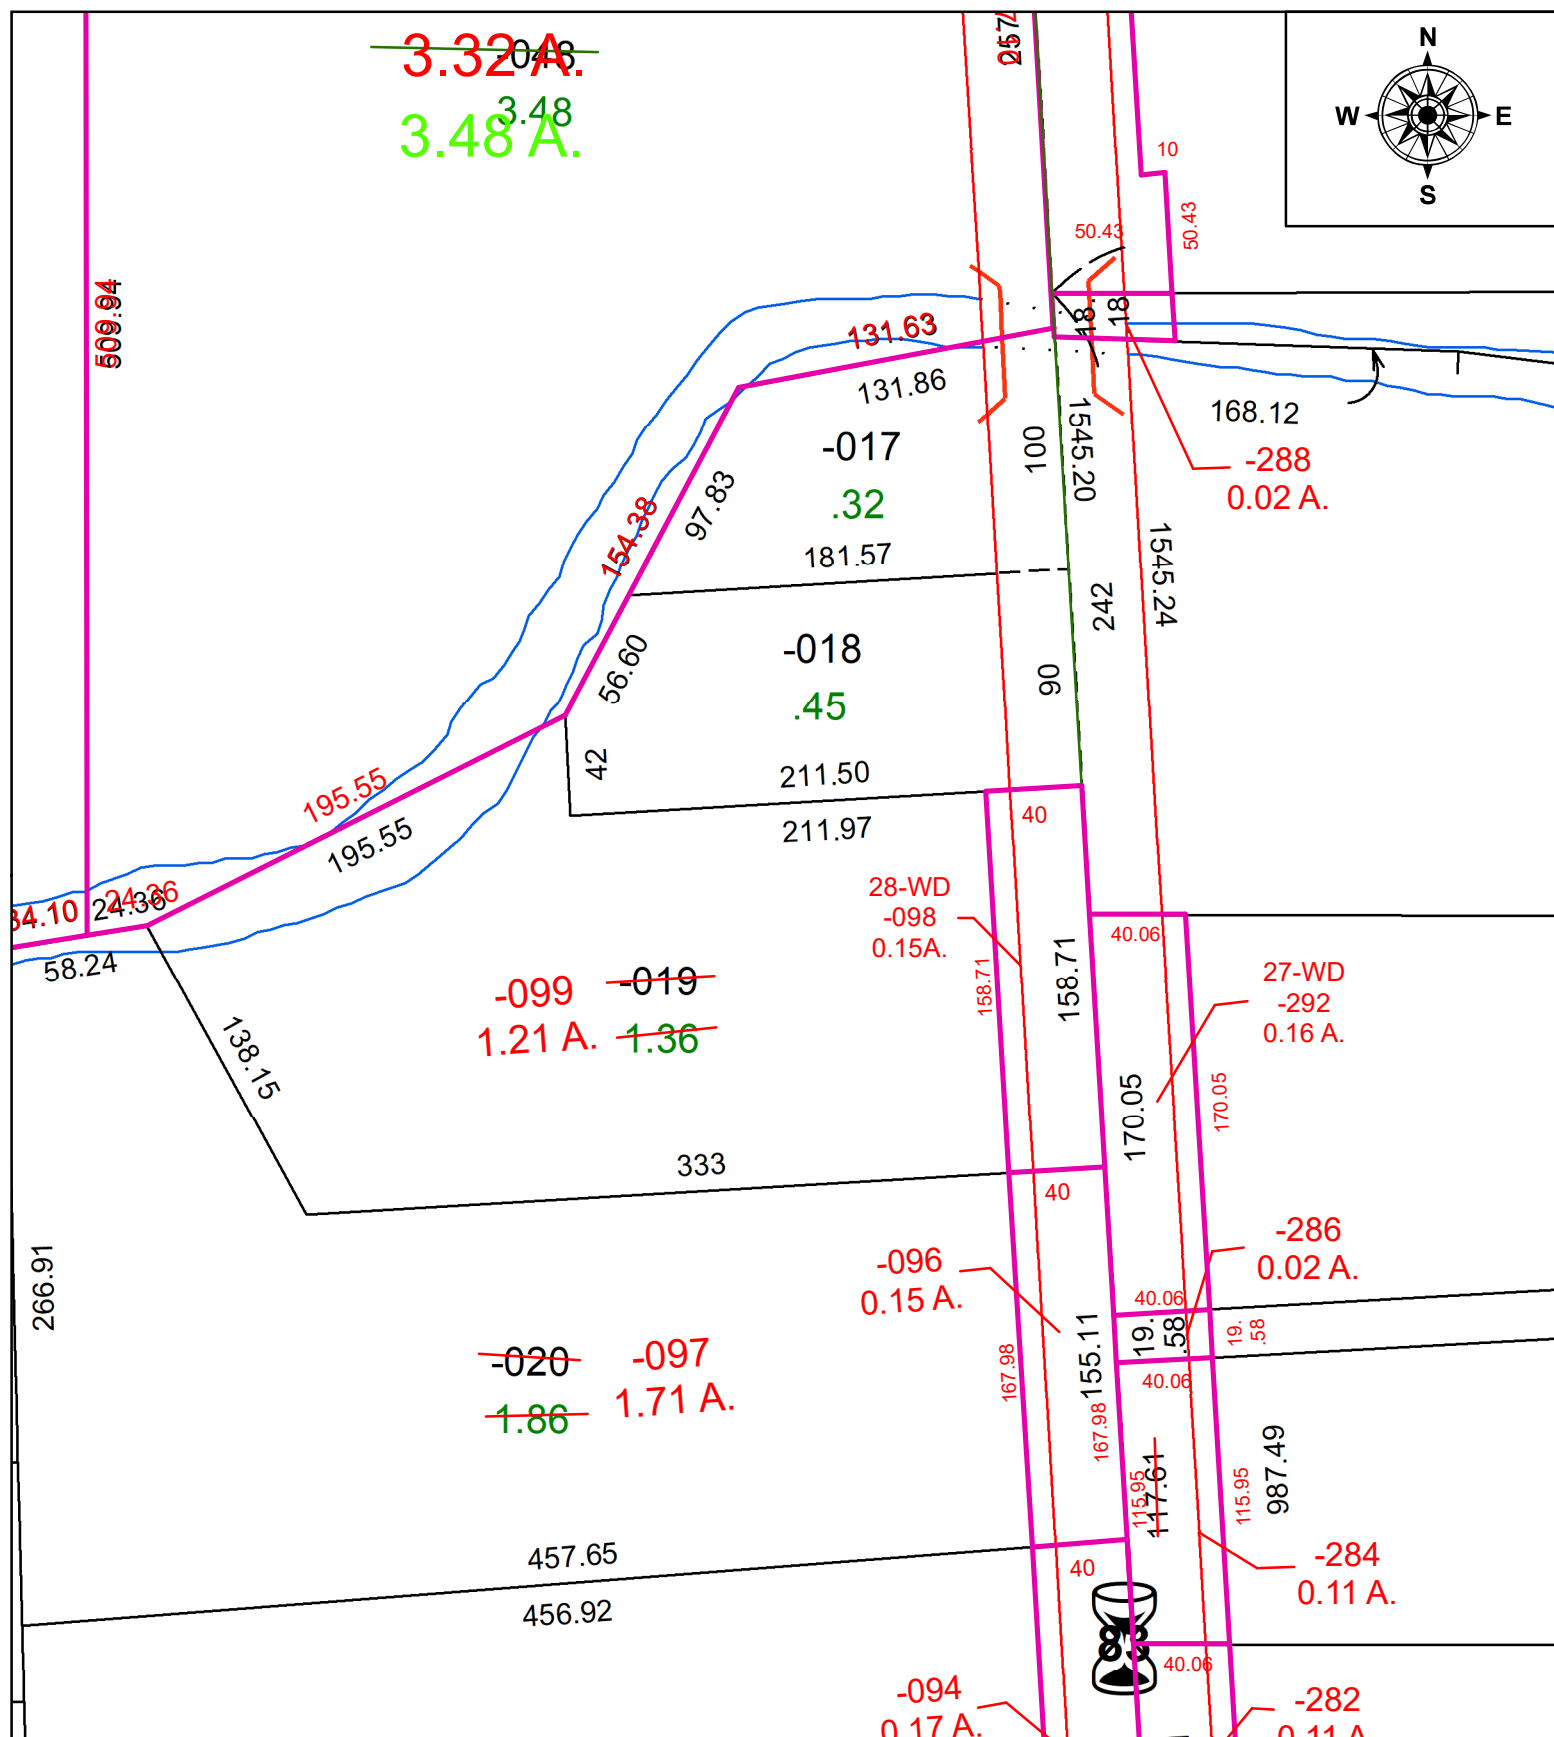


PARENT PARCEL:

CHILD PARCEL:

STARTING POINT:

25-00859

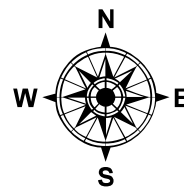

SPLITS/DEEDS PROCESSED

LORAIN COUNTY TAX MAP DEPARTMENT
226 MIDDLE AVE. ELYRIA, OH

SURVEYED BY: DONALD SHEEHY

CLOSURE: 1: INF

MAP PAGE(S): 04-00-014

APPROVED BY: TJS **DATE:** 5/2/2025

SCALE: $1" = 80'$

PRIOR INSTRUMENT: 2021-0854176