
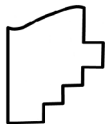
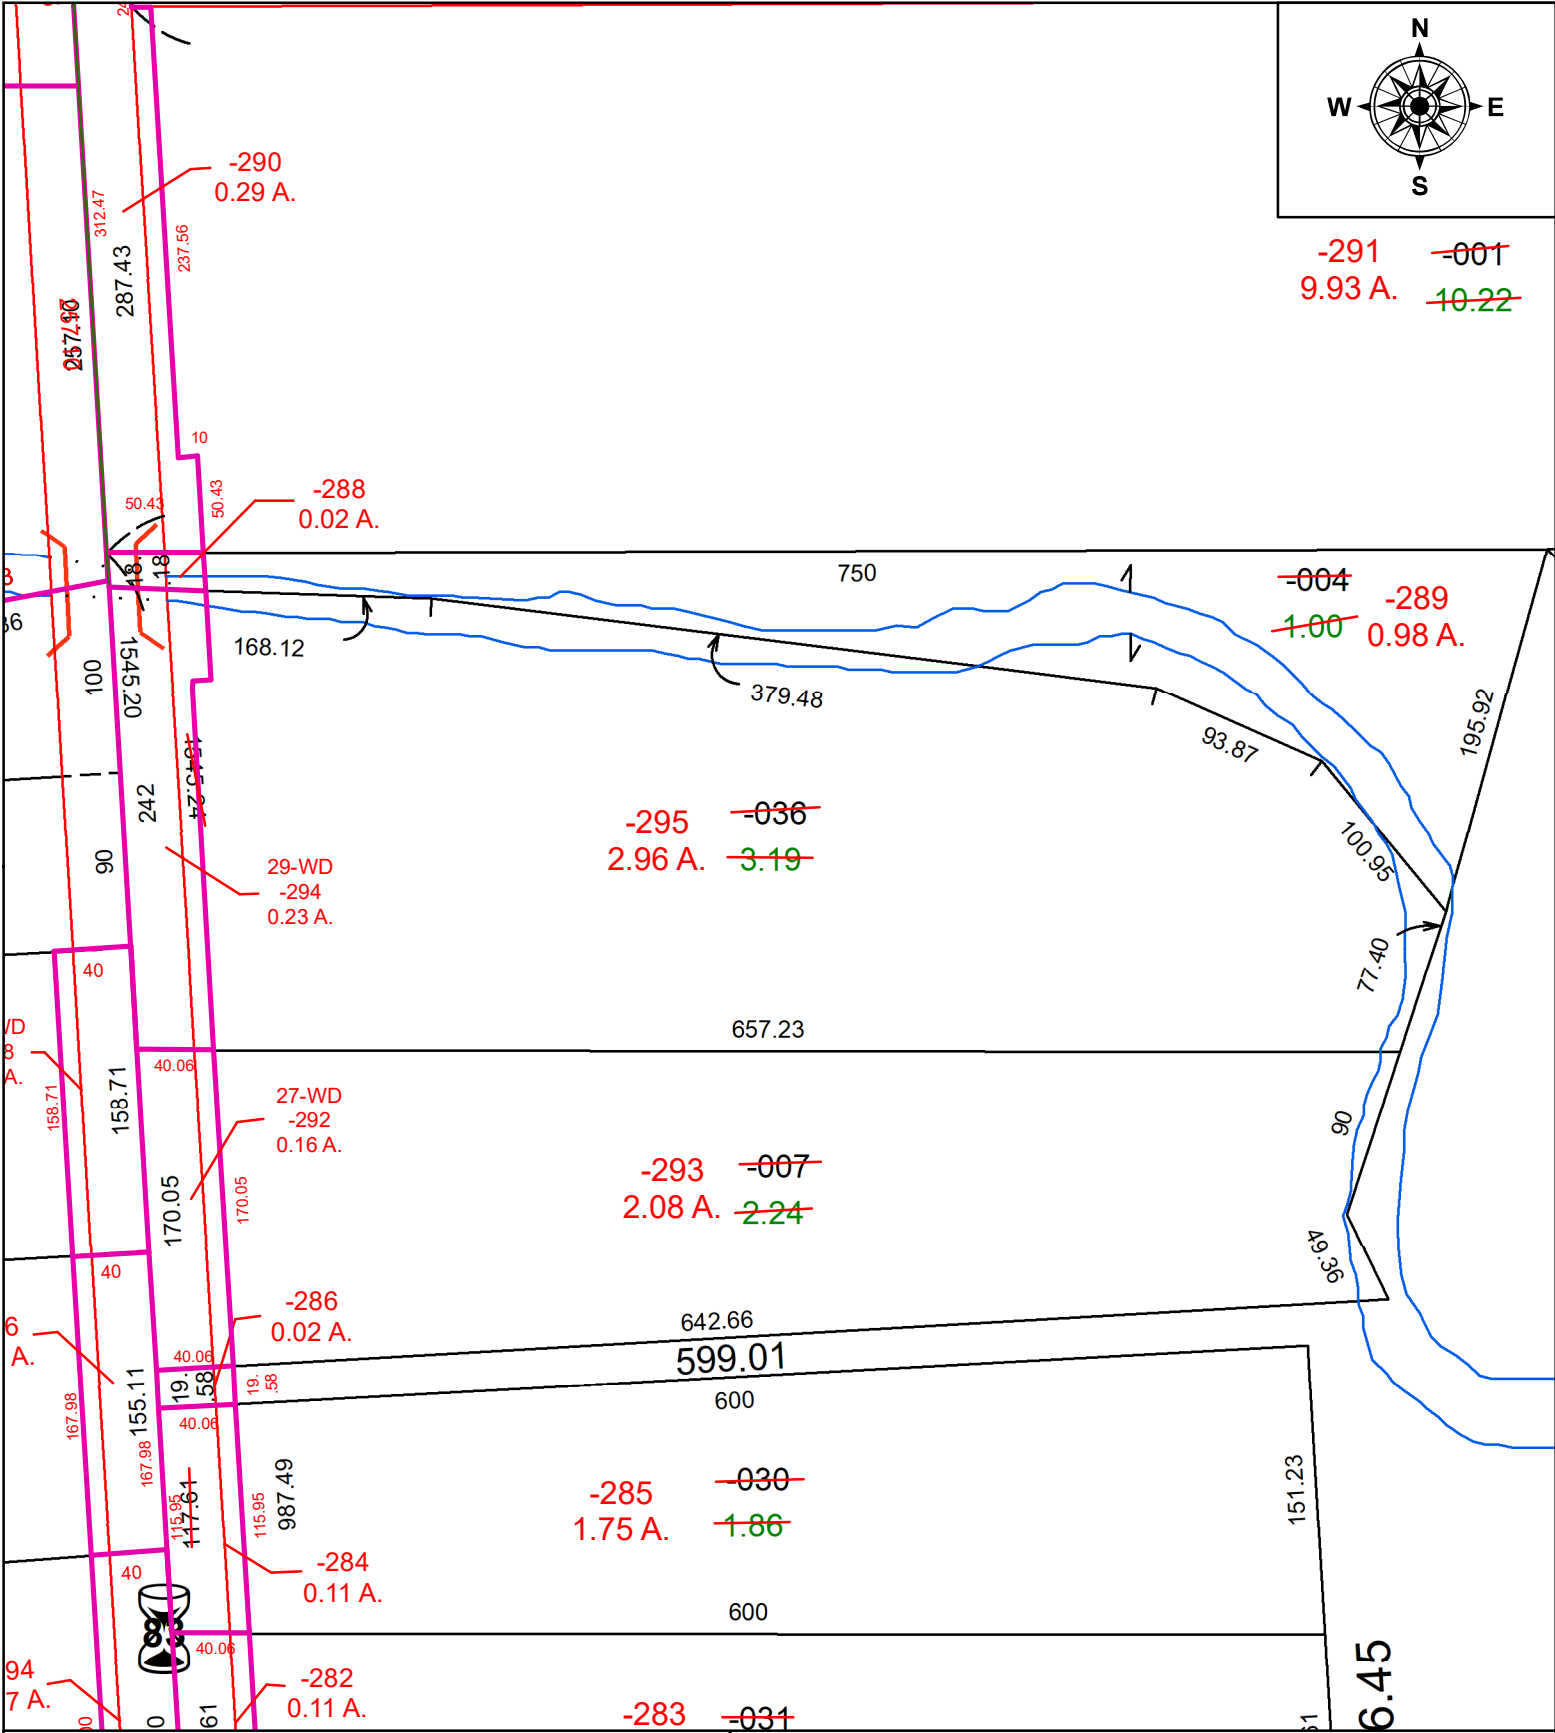


PARENT PARCEL: 04-00-014-107-036
CHILD PARCEL: 04-00-014-107-294 & -295 29-WD LOR-83-16.76
STARTING POINT: I.P. MON. BOX, CL OF WYNDEMERE WAY & EAST R.O.W. OF CENTER RD. (S.R. 83)

25-00860

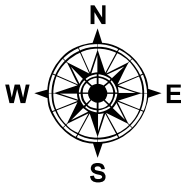

SPLITS/DEEDS PROCESSED
LORAIN COUNTY TAX MAP DEPARTMENT
226 MIDDLE AVE. ELYRIA, OH

SURVEYED BY: DONALD SHEEHY
CLOSURE: 1: INF
MAP PAGE(S): 04-00-014
APPROVED BY: TJS DATE: 5/5/2025
SCALE: 1" = 100' PRIOR INSTRUMENT: 2021-0833926