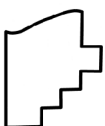
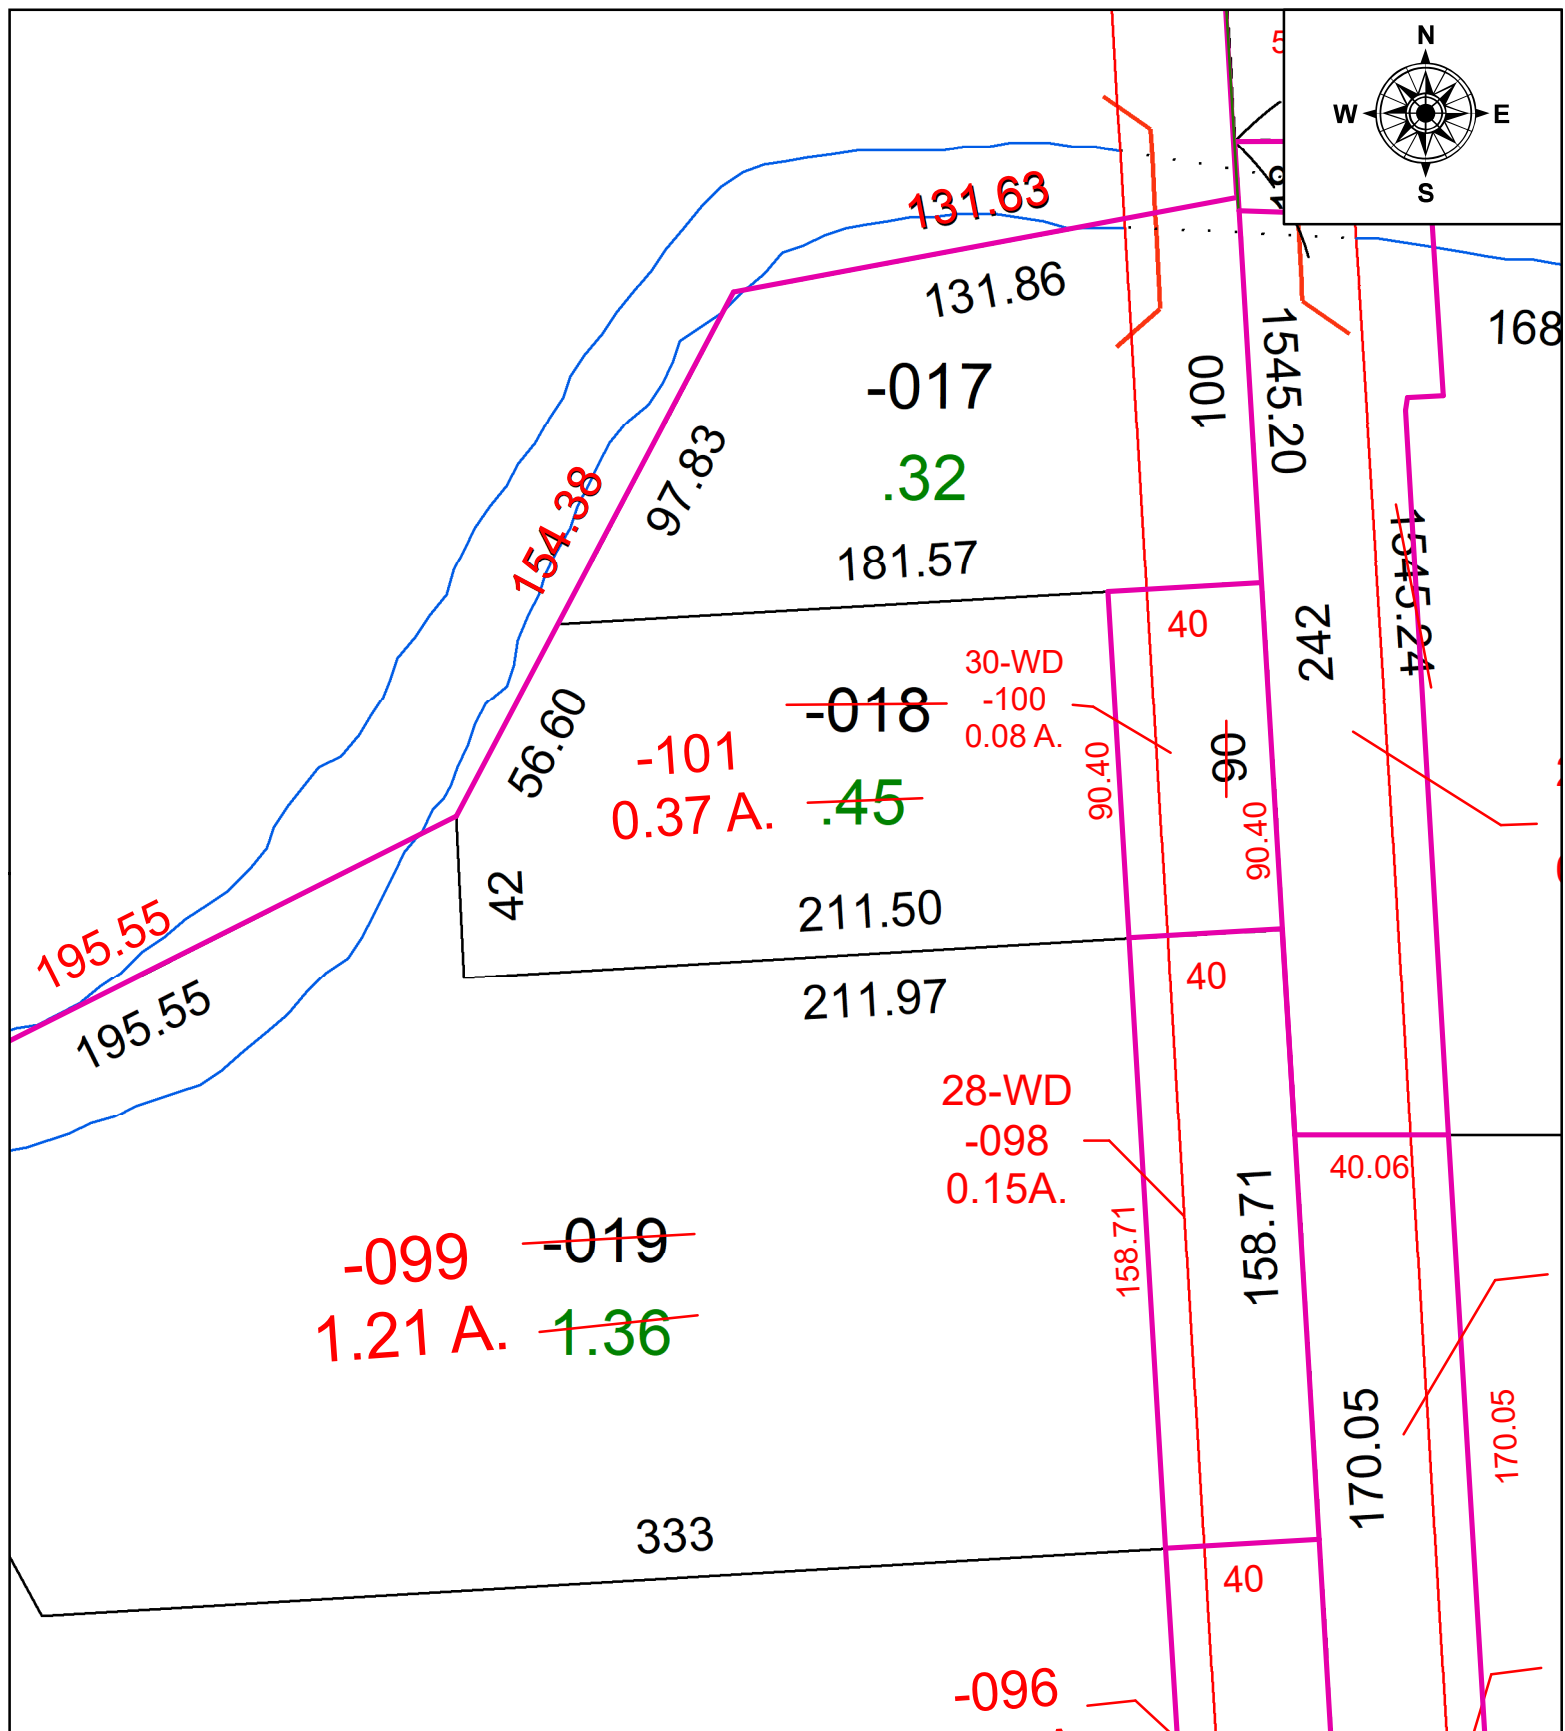


25-00861

**SPLITS/DEEDS PROCESSED**

LORAIN COUNTY TAX MAP DEPARTMENT
226 MIDDLE AVE. ELYRIA, OH

SURVEYED BY: DONALD SHEEHY

CLOSURE: 1: INF

MAP PAGE(S): 04-00-014

APPROVED BY: TJS **DATE:** 5/5/2025

SCALE: 1" = 50' PRIOR INSTRUMENT: 2021-0806524