
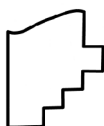
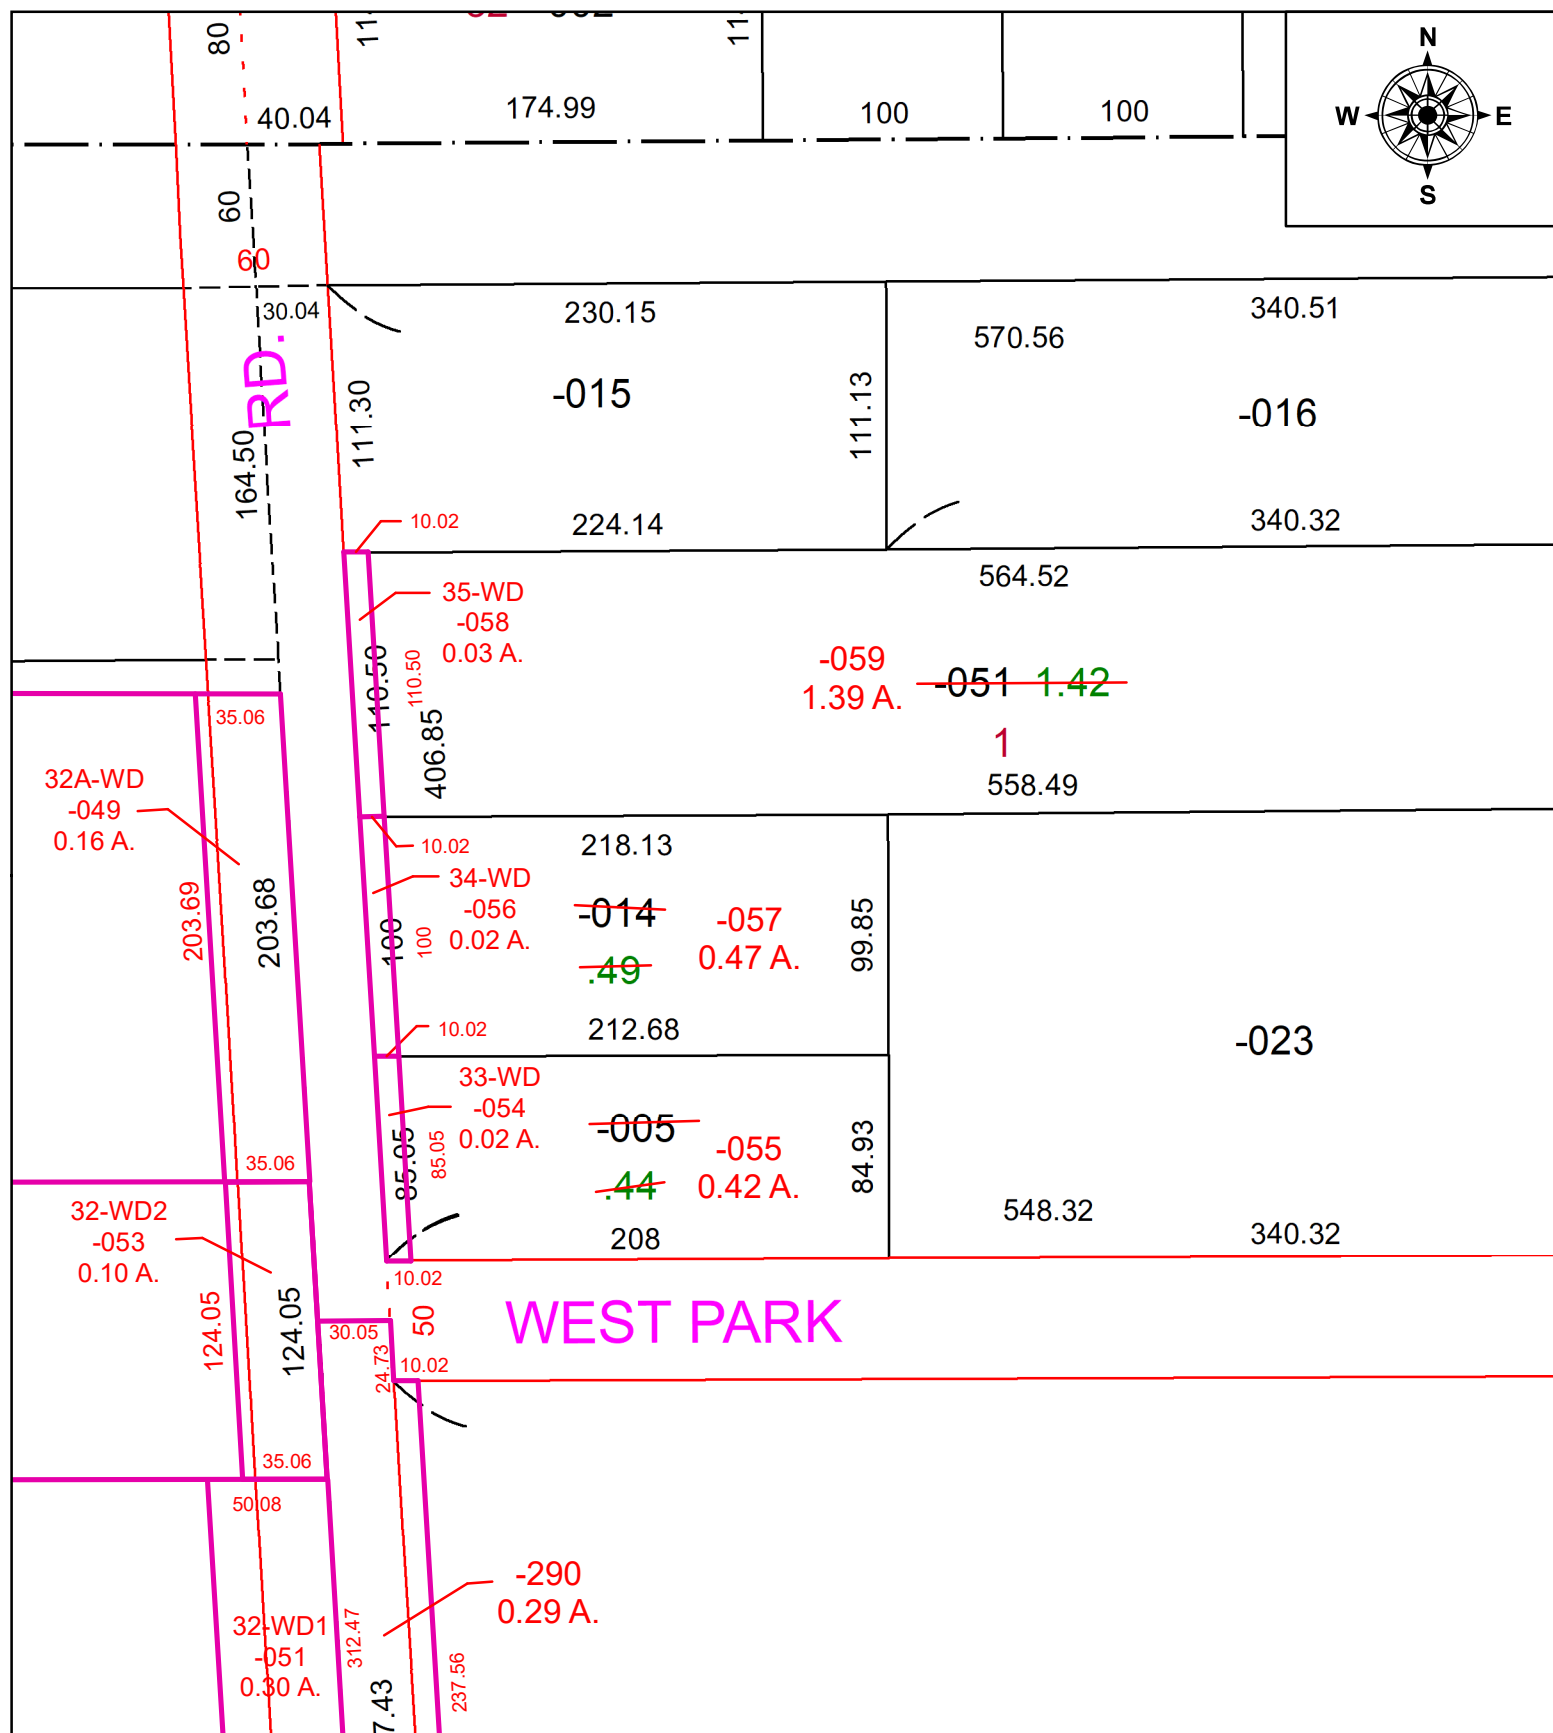


25-00867

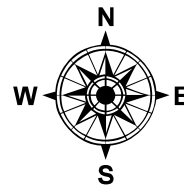

SPLITS/DEEDS PROCESSED

LORAIN COUNTY TAX MAP DEPARTMENT
226 MIDDLE AVE. ELYRIA, OH

SURVEYED BY: DONALD SHEEHY

CLOSURE: 1: INF

MAP PAGE(S): 04-00-014

APPROVED BY: TJS **DATE:** 5/13/2025

SCALE: 1" = 80' **PRIOR INSTRUMENT:** 2012-0400439